Rice


DX 78-1

KANSAS

Section 4 Township 18 Range 8W

Well No. #6 Kratzer

Company Dozier Oil

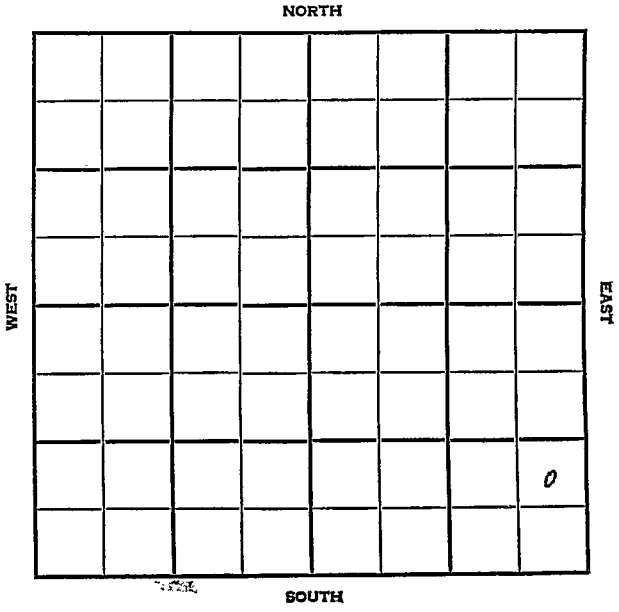

Rice KANSAS

SEC.	TWP.	R.
4	18	8 W

WELL NO.

6 Kratzer FARM

COMPANY

Dozier Oil

CONTRACTOR

Lewis Drlg.

Geneseo-Edwards Pool

NORTH

_____ Ft. from N. Line

990 Ft. from S. Line

330 Ft. from E. Line

_____ Ft. from W. Line

WEST

EAST

SOUTH

NE SE SE

1955	ELEVATION 1765' REPORT
1/12	Location
3/9	Spud 2-2-55 Oil Well TD 3300' 8-5/8" @ 225' Heeb. 2694', Br. Lime. 2 818' Lans 2844', Cong. 3198', Simp 3207' Arb. 3250' TD 3300' 5" @ 3299' CO 10/ 3276-79 HFW SP 3273 6/ 3267-69 FU 1500' oil Comp 110 bopd. 5% Wtr.

COMPLETED

DX-78

FORM 275 FOR SALE BY KANSAS BLUE PRINT CO.


County Rice State Kansas

Sec. 4 (Blk. Twp.) 18 (Sur. Rge.) 8W Map No.

Operator Dozier Oil

Well No. 6 Farm Kratzer

Elev. Location NE SE SE

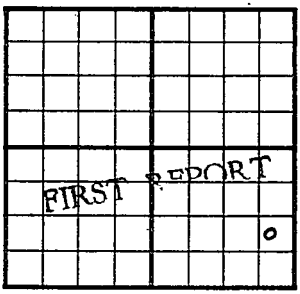

990 Ft. From S Line SE

330 Ft. From E Line Quarter

1st. Report JAN 1 2 1955

Completion

Remarks

Lewis Drlg. - Contr.

Spudding Date

Drlg. Data Geneseo-Edwards Pool

Location

FABEN GILSTRAP

FORM 275 FOR SALE BY KANSAS BLUE PRINT CO.


County Rice State Kansas

Sec. 4 (Blk. Twp.) 18 (Sur. Rge.) 8W Map No.

Operator Dozier Oil

Well No. 6 Farm Kratzer

Elev. 1765 Location NE SE SE

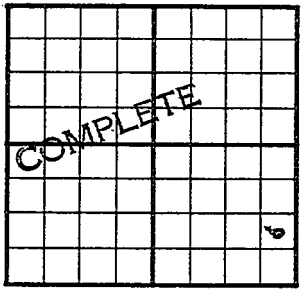

990 Ft. From S Line SE

330 Ft. From E Line Quarter

1st. Report

Completion MAR 9 1955

Remarks Geneseo-Edwards Pool
Lewis Drlg. - Contr.

Spudding Date 2-2-55

Drlg. Data Oil well TD 3300

8 5/8" @ 225 Heeb. 2694 Br. lime 2818

Lans. 2844 Cong. 3198 Simp. 3207

Arb. 3250 TD 3300 5" @ 3299

CO 10/ 3276-79 HFW SP 3273

6/ 3267-69 FU 1500' oil

Comp. 110 bopd 5% wtr.

FABEN GILSTRAP