
DX 78-1

Rice KANSAS

Section 4 Township 18 Range 8W

Well No. 7 Kratzer

Company Dozier Oil

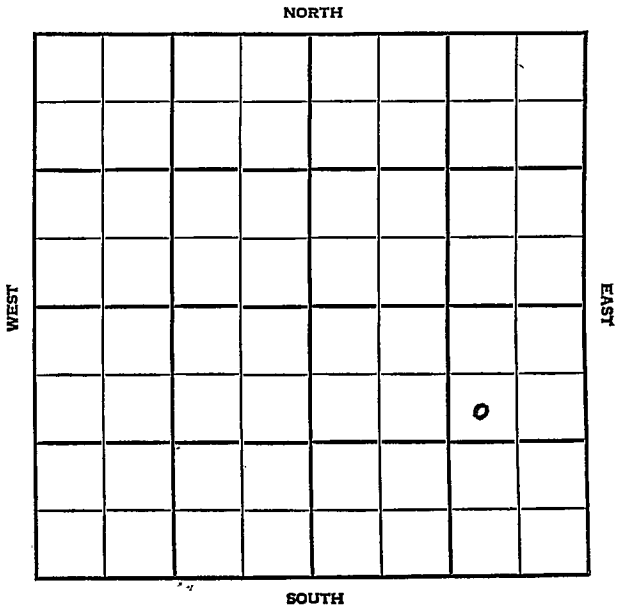

Rice KANSAS

SEC.	TWP.	R.
4	18	8 W

WELL NO.

7 Kratzer FARM

COMPANY

Dozier Oil

CONTRACTOR

Stag Drlg.


990 Ft. from N. Line

Ft. from S. Line

990 Ft. from E. Line

Ft. from W. Line

SW NE SE

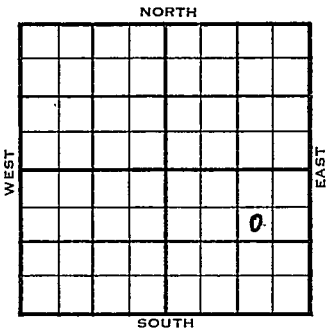

ELEVATION

1955 1766' REPORT

2/23 Location
Spud 2-23-55
Oil Well
TD 3300'
8" @ 215'
Heeb.2702', Br lime 2821', Lans 2849',
Cong 3196', Simp. 3206'
DST 3197-3215', opn ½ hrs., rec. 20' mud, 0#
3/30 Arb.3249'
TD 3300'
5" @ 3299'
CO 14/3247-50, FU 600' oil 1 hr., S/10 BOPH 6 hrs.
Comp. 124 bopd

COMPLETED

DX-78

FORM 275 FOR SALE BY KANSAS BLUE PRINT CO.


County Rice State Kansas

Sec. 4 (Blk. Twp.) 18 (Sur. Rge.) 8W Map No.

Operator Dozier Oil

Well No. 7 Farm Kratzer

Elev. 1766 Location SW NE SE

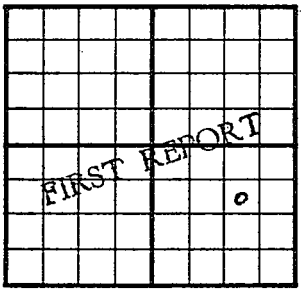

990 Ft. From N Line SE

990 Ft. From E Line Quarter

1st. Report FEB 2 3 1955

Completion

Remarks

Spudding Date

Drlg. Data

Location

FABEN GILSTRAP

FORM 275 FOR SALE BY KANSAS BLUE PRINT CO.


County Rice State Kansas

Sec. 4 (Blk. Twp.) 18 (Sur. Rge.) 8W Map No.

Operator Dozier Oil

Well No. 7 Farm Kratzer

Elev. 1766 Location SWNE SE

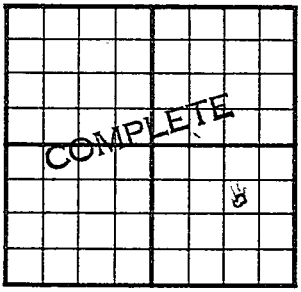

990 Ft. From N Line SE

990 Ft. From E Line Quarter

1st. Report

Completion MAR 3 0 1955

Remarks

Stag Drlg. - Contr.

Spudding Date 2-23-55

Drlg. Data Oil well TD 3300

8" @ 215 Heeb. 2702 Br. lime 2821

Lans. 2849 Cong. 3196 Simp. 3206

DST 3197-3215 open ½ hr. Rec. 20' mud

O# Arb. 3249 TD 3300 5" @ 3299

CO 14/ 3247-50 FU 600' oil 1 hr.

S/ 10 boph 6 hr. Comp. 124 bopd

FABEN GILSTRAP