


Section 4 Township 18 Range 8W

Well No. #1 Rolf

Company Ashmore & Martin

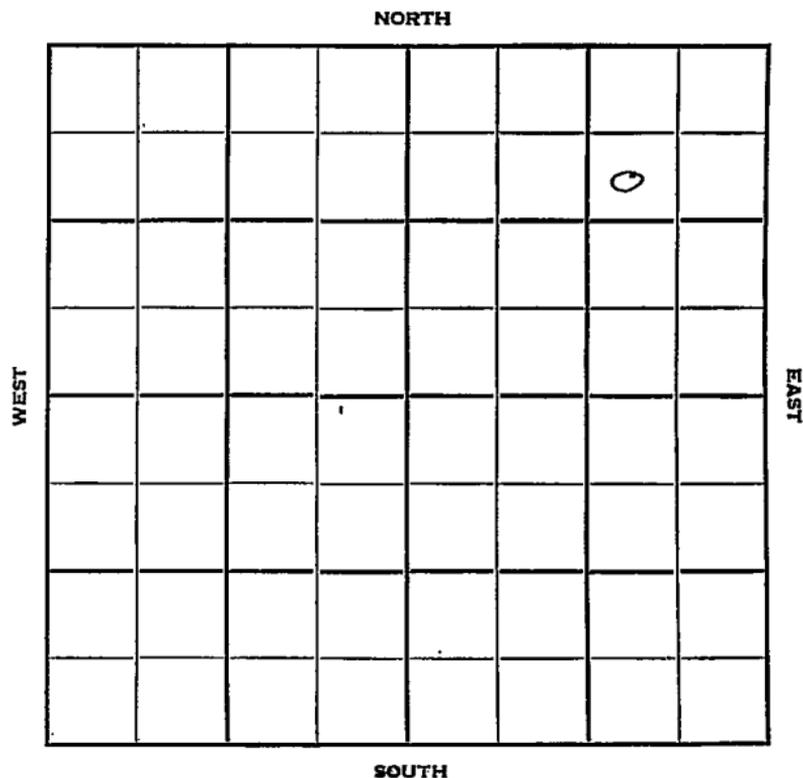

Sec. 4 **O. W. P. B.** Twp. 18 R. 8W

Well No. #1 Rolf Farm

Ashmore & Martin Company

Contractor

Geneseo Pool


990' Ft. from N. Line

_____ Ft. from S. Line

990' Ft. from E. Line

_____ Ft. from W. Line

SW NE NE

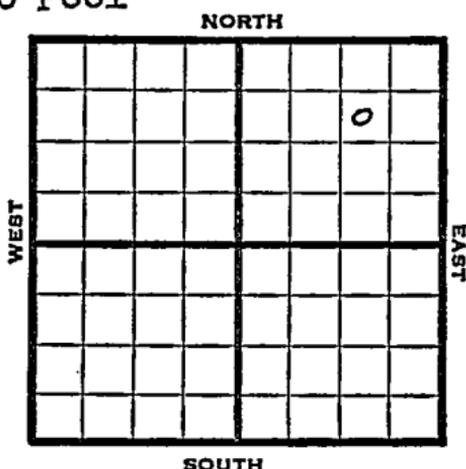

1952 Elev. 1767' REPORT

2/6 RUR

2/13 Drlg. 2368'

2/20 Br Li 2820 Lans. 2846
Cong sd 3208-13 Simp. sh 3228
Arb. 3236
RTD-3241 5" @ 3236'

3/5 No report

3/11 TD 3264 1/2 boph 700 A
S/ 5 1/2 boph POP, tstg.

3/19 "

3/26 Spud 2-5-52
Oil Well TD 3264 8" @ 191
Br Li 2820 Lans. 2846
Cong. 3208-13 Simp. 3288
Arb. 3236 TD 3241 5" @ 3236
DST 3195-3215 open 1 hr. rec. 375'
gas 285' oil & OCM DD 3262
FU 100' oil 1000 A DD 3264
1/2 boph 700JA S/ 5 1/2 boph
Comp. 252 bopd

COMPLETED

OVER

O. W. P. B.

1953
12/2 KC 2846', Cong 3208', Simp 3228',
Arb 3236,
OTD 3264'
5" @ 3236'
PB & Perf Cong sd-frac
S/ 2 boph 6 hr.
12/9 NR
12/30 Oil Well
TD 3264'
KC 2846', Cong 3208', Simp 3228', Arb
3236'
OTD 3264'
5" @ 3236'
PB & perf Cong. sd-frac S/ 2 boph
6 hr.
PB 3215
20/ 3208'-13' sd-oil-frac
Comp 43 bopd.

COMPLETED

