


Section 4 Township 18 Range 8W

Well No. #1 Wuthnow

Company Stagg Drlg. et al

NORTH

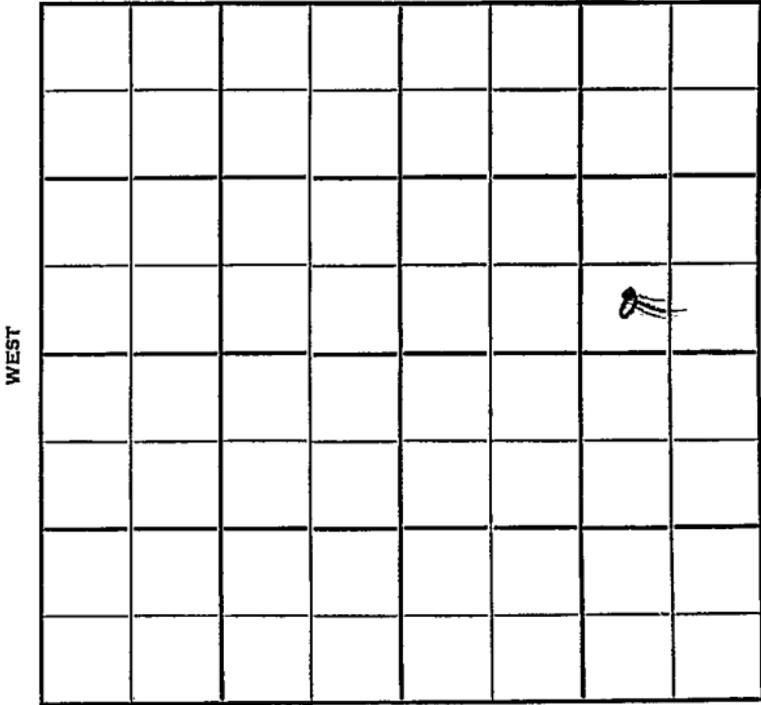

SOUTH

WEST

EAST

Rice

KANSAS

Sec. 4 Twp. 18 R. 8W

Well No. #1 Wuthnow Farm

Stagg Drlg. et al Company

Stagg Drlg. Contractor

Edwards Pool


NORTH

Ft. from N. Line

330 Ft. from S. Line

990 Ft. from E. Line

Ft. from W. Line

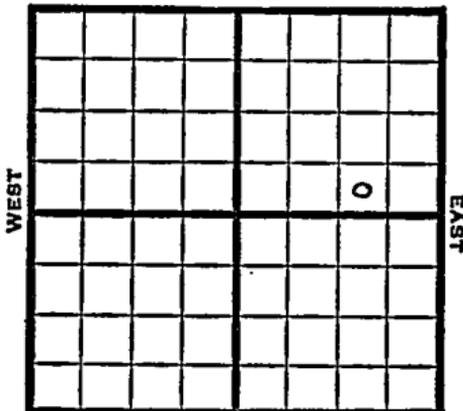

SW SE NE

SOUTH

1952

Elev. 1767' REPORT

1/2

Spud 12-26-51
8" @ 212'

Drlg. 2165'

1/30

Spud 12-26-51
Oil Well TD 3295
8" @ 212

Heeb. 2718 Br Li 2838

Lans. 2865 Cong. 3230

Simp. 3261 TD 3295

5" @ 3285 Go to 3295

Fu 2400' wtr. SP 3266

43/ 3232-43 S/ 3 boph

Comp. 45 bopd

COMPLETED


County Rice State Kansas

Sec. 4 (Blk. Twp.) 18 (Sur. Rge.) 8W Map No.

Operator Stagg Drlg. et al.

Well No. 1 Farm Wuthnow

Elev. Location SW SE NE

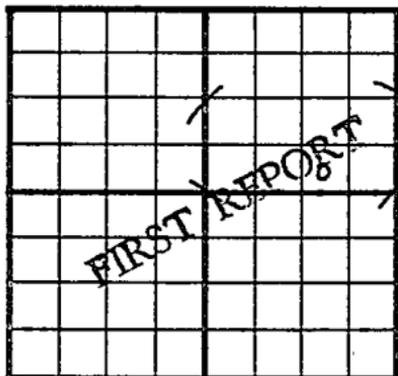

350 Ft. From S Line NE

990 Ft. From E Line Quarter

1st. Report JAN 2 1952

Completion

Remarks

Stagg Drlg. - Contr.

Spudding Date 12-26-51

Drlg. Data Edwards Pool

8" @ 212 drlg. 2165

J. E. TYRA


County Rice State Kansas

Sec. 4 (^{Bk.}Twp.) 18 (^{Sur.}Rge.) 8W Map No.

Operator Stagg Drilg. etal.

Well No. 1 Farm Wuthnow

Elev. 1767 Location SW SE NE

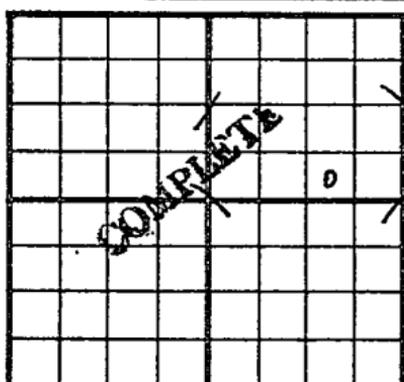

330 Ft. From S Line NE

990 Ft. From E Line Quarter

1st. Report

Completion JAN 30 1952

Remarks Edwards Pool

Stagg Drilg. - Contr.

Spudding Date 12-26-51

Drilg. Data Oil well TD 3295

8" @ 212 Heeb. 2718 Br. lime 2838

Lans. 2865 Cong. 3230 Simp. 3261

TD 3295 5" @ 3285 CO to 3295

FU 2400' water SP 3266 43/ 3232-43

S/ 3 boph Comp. 45 bopd

J. G. McGEHEE