


Section 4 Township 18 Range 8 W

Well No. # 2 Wuthnow

Company Dozier Oil

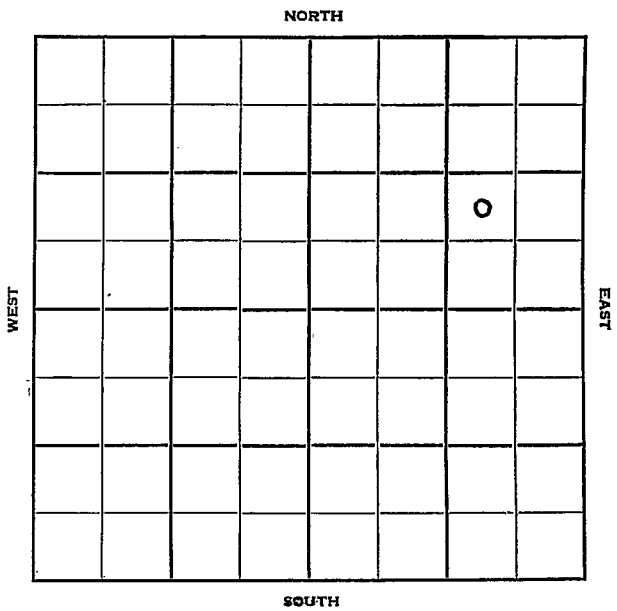

Sec. 4 Twp. 18 R. 8W

Well No. #2 Wuthnow Farm

Dozier Oil Company

Stagg Contractor


 Ft. from N. Line

990 Ft. from S. Line

990 Ft. from E. Line

 Ft. from W. Line

NW SE NE

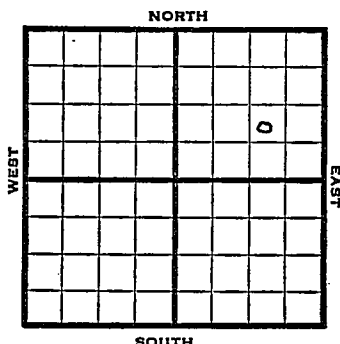

1952 Elev. 1765' REPORT

3/12 Location

3/19 8" @ 217 Drlg. 2550'

3/25 Heeb. 2710 Br Li 2827
KC 2853 Cong. 3210
Arb. 3236 RTD 3243

5" @ 323 WOC
4/1 CO to 3243, 150' oil 4 hrs. 500 A
S/ 5 BOPH POP

4/9 "

4/16 Spud 3-12-52
Oil Well TD 3249'
8" @ 217'

Heeb. 2710 Br Li 2827
KC 2853 Cong. 3210
Arb. 3236

TD 3243' 5" @ 3238 CO to 3243
DD 3249 FU 150' oil 4 hr.
500 A S/ 5 boph.
Comp. 172 bopd


COMPLETED

County Rice State Kansas
 Sec. 4 (Blk. 18 (Sur. 8W Map No. 18)
 (Twp.) (Rge.)

Operator Dozier Oil

Well No. 2 Farm Wuthnow

Elev. _____ Location NW SE NE

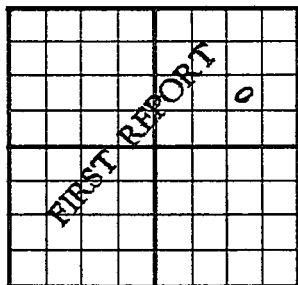

990 Ft. From S Line NE

990 Ft. From E Line Quarter

1st. Report MAR 1 2 1952

Completion _____

Remarks _____

Stagg - Contr.

Spudding Date _____

Drlg. Data _____

Location

J. G. McGEHEE

