


Section 4 Township 18 Range 8 W

Well No. # 3 Withnow

Company Dozier Oil

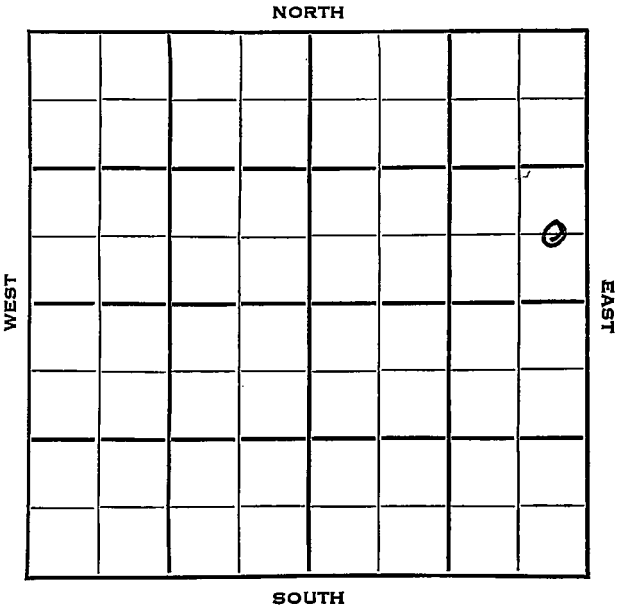

Rice

KANSAS ✓

Sec. 4 Twp. 18 R. 8WWell No. #3 Wuthnow FarmDozier Oil


Company

Stag Drlg.

Contractor

Geneseo Pool Ft. from N. Line660 Ft. from S. Line330 Ft. from E. Line Ft. from W. Line

C E L S E N E

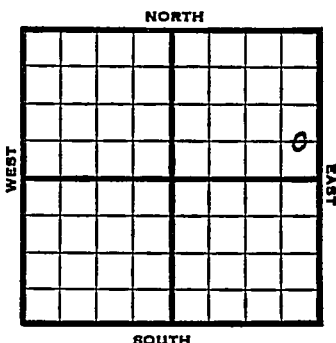

1953

Elev. 1771' REPORT

5/27 M I R

6/3 8" @ 217'
Drlg 2615'6/10 Lans 2846, B KC 3145, Cong 3201, Arb
3224,
RTD 3294
5" @ 3293 C.O.6/24 Spud 5-26-53 Oil well TD 3294
8" @ 217 Lans 2846' B KC 3145'
Cong. 3201' Arb. 3224' TD 3294
5" @ 3293 GO to 3294 S/20 BOPH
4 hr. Perf/3226-30 500 A
S/20 BOPH
Comp. 3000 BOPD**COMPLETED**

County

Rice

State

Kansas

Sec.



(Blk.)
(Twp.)

7:2

(Sur.)
(Rge.)

214

Map No.

Operator

Dozier oil

Well No.

3

Farm

[illegible]

Elev.

Location

FALSE

0

FIRST REPORT

660 Ft. From

S Line

3412

330 Ft. From

F Line

Quarter

1st. Report

MAY 27 1953

Completion

Remarks

Stag Drlg. - Contr.

Spudding Date

Drig. Data

Genesee Pool

REF R

J. G. MCGEEHEE

J. G. McGEHEE