


Section 4 Township 18 Range 8W

Well No. #5 Kratzer

Company Dozier Oil

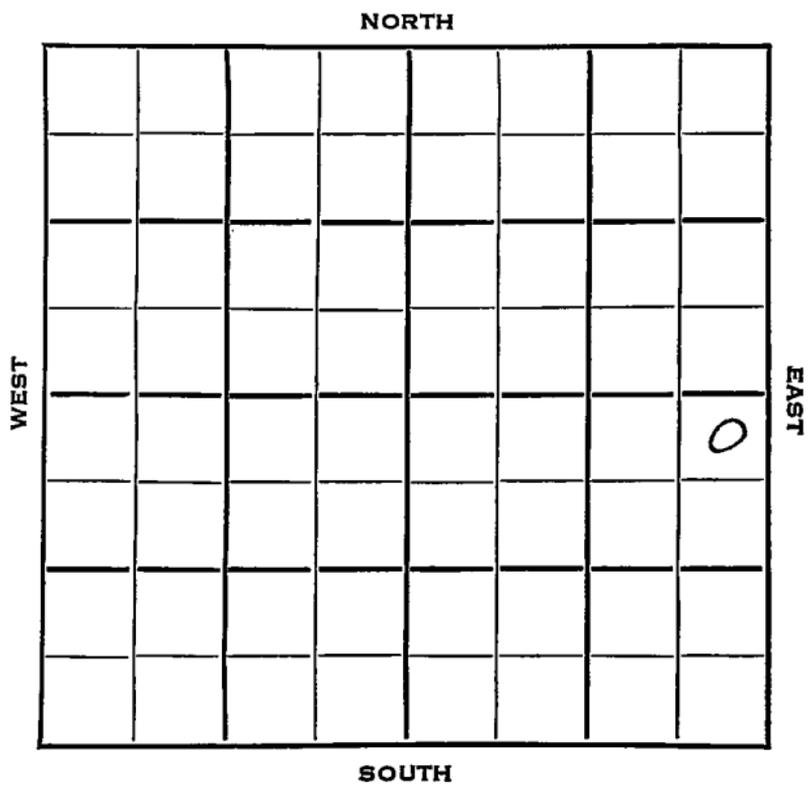

Rice KANSAS


SEC.	TWP.	R.
4	18	8W ✓

WELL NO. **5 Kratzer** FARM

COMPANY **Dozier Oil**

CONTRACTOR **Lewis Drlg.
Geneseo Pool**

330 Ft. from N. Line
 _____ Ft. from S. Line
330 Ft. from E. Line
 _____ Ft. from W. Line

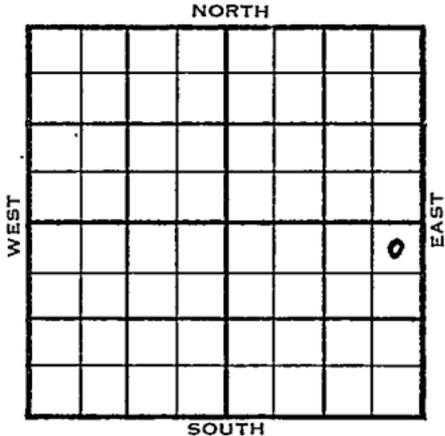

NE NE SE

	ELEVATION	REPORT
1954	1771'	
1/6	MIR	
1/13	8" @ 228'	
	w/150	
	Heeb 2708', Br li 2828'	
	Drlg. 3010'	
1/20	Lans 2852', Simp 3220', Arb. 3285'	
	RTD 3310'	
	5" @ 3310'	
1/27	6/3299-3301, 1 1/2 bwph	
	PB 3295, 6/3288-90, S/7 bo + trace	
	wph 5 hrs.	
2/3	NR	
2/10	Spud 1-7-54	
	Oil Well	
	TD 3310'	
	8" @ 228'	
	Heeb 2708', Br. Lime 2828', Lans 2852'	
	Simp 3220', Arb 3285'	
	TD 3310'	
	5" @ 3310'	
	6/ 3299-3301 1 1/2 bwph PB 3295	
	6/ 3288-90 S/ 7 boph	
	Comp 56 bopd.	

COMPLETED

