FORM 51

Rice KANSAS

Section 4 Township 18 Range 8 W

Well No. # 2 Rolfs

Company Ash-Mar Drlg.

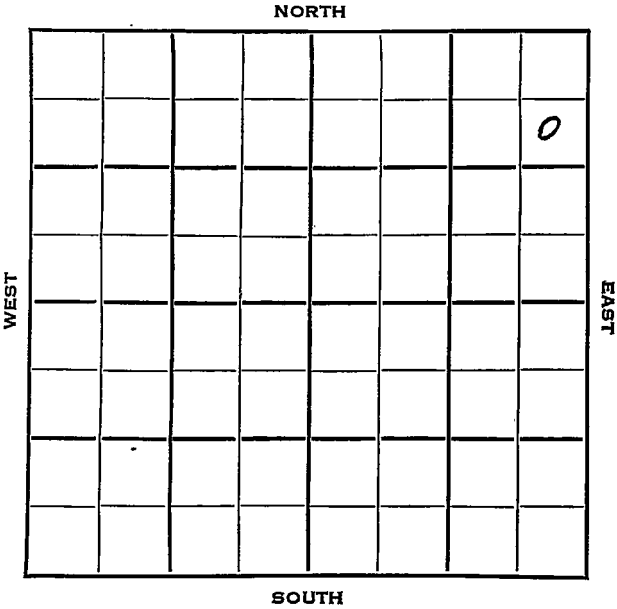

Rice KANSAS

SEC.	TWP.	R.
4	18	8W

WELL NO. #2 Rolfs FARM

COMPANY Ash-Mar Drlg.

CONTRACTOR Ash-Mar

Edwards Pool

890 Ft. from N. Line

Ft. from S. Line

330 Ft. from E. Line

Ft. from W. Line

SE NE NE

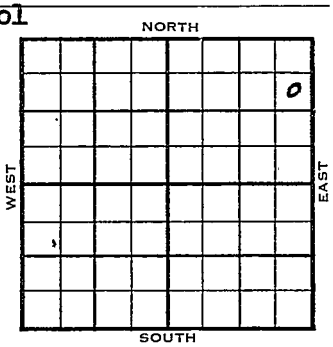

1953	ELEVATION 1771' REPORT
10/28	Spud 10-21-53 8" @ 180' Anhy 570' Drlg 2373'
11/4	Heeb 2707', Br li 2826', Lans 2852, Cong 3202', Arb. 3236' RTD 3282' 5" @ 3281'
11/11	CO 3278' 18/3274-78', S/1/2 boph 6 hrs., 250A S/24 BO + 18 BWPH 1000' OB 2 hrs. S/26 BO + 19 BW 1 hrs., POP
11/18	NR
12/2	Spud 10-21-53 Oil Well TD 3282' 8" @ 180' Anhy 570', Heeb 2707', Br lime 2826', Lans 2852', Cong 3202', Arb. 3236' TD 3282' 5" @ 3281' CO to 3278', 18/3274-78, S/½ boph 6 hrs., 250A, S/24 bo 18 bwph S/26 bo 19 bw 1 hrs. Comp. 168 bopd 50% wtr.

DX-78

COMPLETED

FORM 275 FOR SALE BY KANSAS BLUE PRINT CO.

County Rice State Kansas

Sec. 4 (Blk. Twp.) 18 (Sur. Rge.) 8W Map No.

Operator Ash-Mar Drlg.

Well No. 2 Farm Rolfs

Elev. Location SE NE NE

							o

FIRST REPORT

890 Ft. From N Line NE

330 Ft. From E Line Quarter

1st. Report OCT 28 1953

Completion

Remarks

Ash-Mar - Contr.

Spudding Date 10-21-53

Drlg. Data Edwards Pool

8" @ 180 Anhy 570 drlg. 2373

J. G. McGEHEE

FORM 275 FOR SALE BY KANSAS BLUE PRINT CO.

County Rice State Kansas

Sec. 4 (Blk. Twp.) 18 (Sur. Rge.) 8W Map No.

Operator Ash-Mar Drlg.

Well No. 2 Farm Rolfs

Elev. 1771 Location SE NE NE

							o

COMPLETE

890 Ft. From N Line NE

330 Ft. From E Line Quarter

1st. Report

Completion DEC 2 1953

Remarks Edwards Pool

Ash-Mar - Contr.

Spudding Date 10-21-53

Drlg. Data Oil well TD 3282

8" @ 180 Anhy 570 Heeb. 2707

Br. lime 2826 Lans. 2852 Cong. 3202

Arb. 3236 TD 3282 5" @ 3281

CO to 3278 18/ 3274-78 S/ ½ boph

6 hr. 250 A S/ 24 bo 18 bwph

S/ 26 bo 19 bw 1 hr.

Comp. 168 bopd 50% wtr.

J. G. McGEHEE