


Section 5 Township 18 Range 8 W

Well No. # 1 Myerly

Company Keyes Drlg.

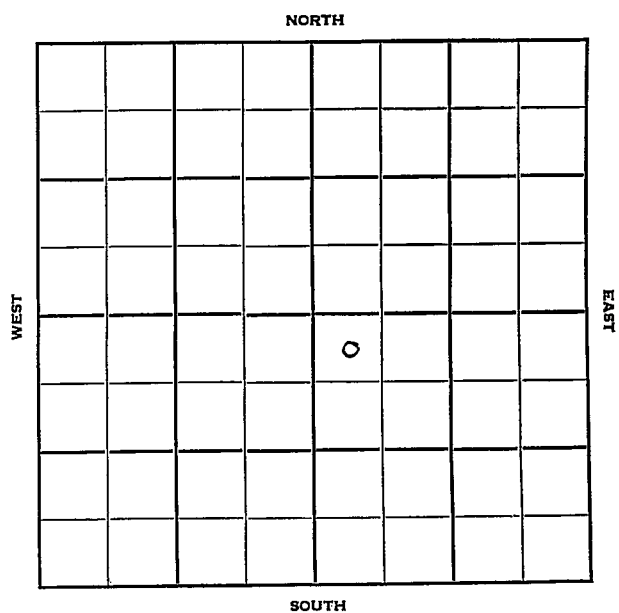

Rice

KANSAS

Sec. 5 Twp. 18 R. 8 W

Well No. # 1 Myerly Farm

Keyea Drlg. Company

Todd Drlg.-Contr. Contractor


330 Ft. from N. Line

Ft. from S. Line

Ft. from E. Line

330 Ft. from W. Line

NW NW SE

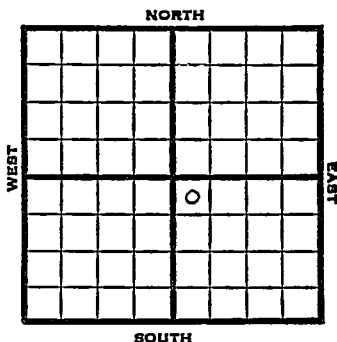

1951

Elev. 1761'

REPORT

5/9

Location

5/29

D&A TD 3485

8" @ 193 Heeb. 2749

Br Lime 2867 Lans. 2890

BKC 3208 Cong. 3261

DST 3263-85 opn 45 min

Rec. 780' gassy SW

Kinderhook 3284 Viola 3363

Simp 3416 Arb. 3469

TD 3485 D&A

ABANDONED

County **Rice** State **Kansas**

Sec. 5 (Blk. Twp.) 18 (Sur. Rge.) 8W Map No.

Operator Keyes Drlg.

Well No. **1** Farm **Myerly**

Elev.	1761	Location	NW NW SE
-------	------	----------	----------

FIRST REPORT

330 Ft. From N Line SE

330 Ft. From W Line Quarter

1st. Report MAY 9 1951

Completion


Remarks

Spudding Date _____

Drilg. Data

Location

J. E. TYRA

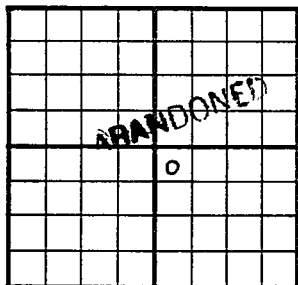County Rice State KansasSec. 5 (Blk.) 18 (Sur.) 8W Map No.Operator Keyes Drlg.Well No. 1 Farm MyerlyElev. 1761 Location NW NW SE330 Ft. From N Line SE330 Ft. From W Line Quarter

1st. Report

Completion MAY 29 1951

Remarks

Todd Drlg. - Contr.

Spudding Date

Drlg. Data D & A TD 34858" @ 193 Heeb. 2749 Br. lime 2867Lans. 2890 B KC 3208 Cong. 3261DST 3263-85 open 45 min. Rec. 780'gassy SW Kinderhook 3284 Viola 3363Simp. 3416 Arb. 3469 TD 3485" D & A