
FORM 51

Rice KANSAS

Section 4 Township 18 Range 8 W

Well No. # 4 Wuthnow

Company Ash-Mar

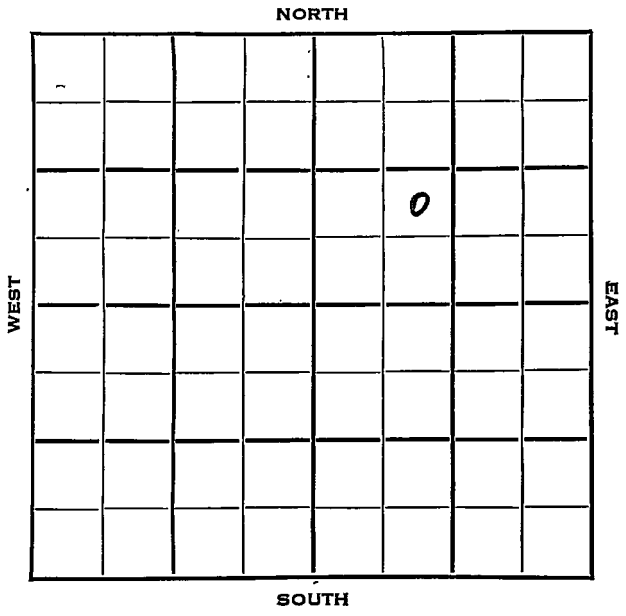

Rice

SEC.	TWP.	R. KANSAS
4	18	8W

WELL NO. #4 Wuthnow FARM

COMPANY Ash-Mar

CONTRACTOR

Edwards Pool


_____ Ft. from N. Line

990 Ft. from S. Line

_____ Ft. from E. Line

990 Ft. from W. Line

NE SW NE

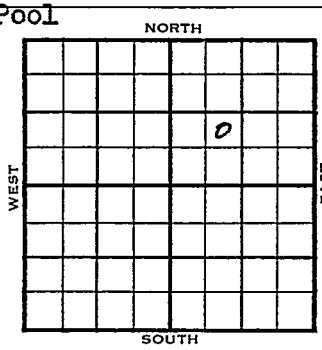

1953	ELEVATION 1765' REPORT
10/14	Spud 10-10-53 8" @ 178' Anhy 575' Drlg 1080'
10/21	Heeb 2723' Br li 2844 Lans 2868 Cong 3217-22 & 2230-34 DST 3208-50'
10/28	Spud 10-10-53 D & A TD 3300 8" @ 178 Anhy 575 Heeb 2723 Br. lime 2844 Lans 2868 Cong. sd. 3217' DST 3208-50 open 1 hr rec 10' mud 422# Ch Cong. 3246' TD 3300' D & A **ABANDONED**

DX-78

FORM 275 FOR SALE BY KANSAS BLUE PRINT CO.


County Rice State Kansas

Sec. 4 (Blk. Twp.) 18 (Sur. Rge.) 8W Map No.

Operator Ash-Mar

Well No. 4 Farm Wuthnow

Elev. Location NE SW NE

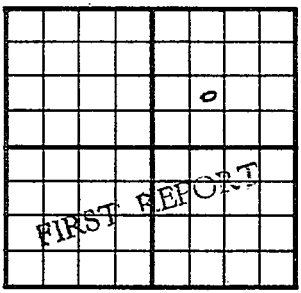

990 Ft. From S Line NE

990 Ft. From W Line Quarter

1st. Report OCT 14 1953

Completion

Remarks

Spudding Date 10-10-53

Drlg. Data Edwards Pool

8" @ 178 Anhy 575 drlg. 1080

J. G. McGEHEE

FORM 275 FOR SALE BY KANSAS BLUE PRINT CO.


County Rice State Kansas

Sec. 4 (Blk. Twp.) 18 (Sur. Rge.) 8W Map No.

Operator Ash-Mar

Well No. 4 Farm Wunthow

Elev. 1765 Location NE SW NE

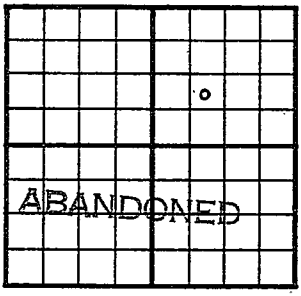

990 Ft. From S Line NE

990 Ft. From W Line Quarter

1st. Report

Completion OCT 28 1953

Remarks Edwards Pool

Spudding Date 10-10-53

Drlg. Data D & A TD 3300

8" @ 178 Anhy 575 Heeb. 2723

Br. lime 2844 Lans. 2868 Cong. sd. 3217

DST 3208-50 open 1 hr. Rec. 10' mud

422# ChCong. 3246 TD 3300

D & A

J. G. McGEHEE