
Rice KANSAS

DX 78-1

Section 4 Township 18 Range 8W

Well No. 5 Wuthnow

Company Martin Oil (was Ash-Mar)

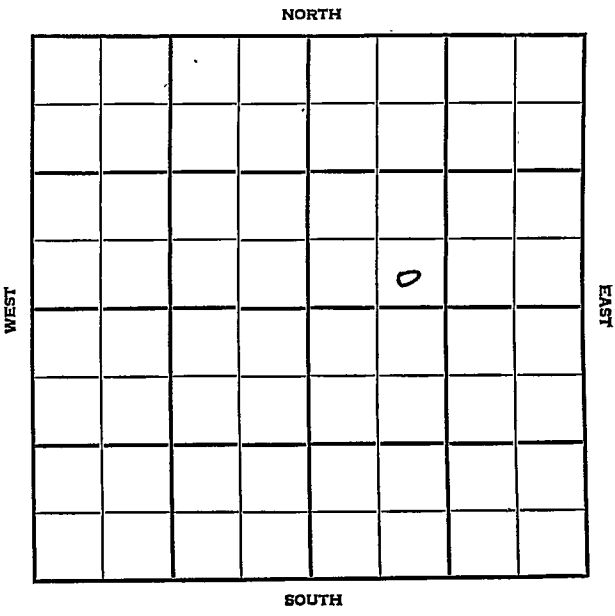

Rice KANSAS

SEC.	TWP.	R.
4	18	8W

WELL NO.

5 Wuthnow FARM

COMPANY

Martin Oil (was Ash-Mar)

CONTRACTOR

B.E. Ash


Geneseo Pool

_____ Ft. from N. Line

330 Ft. from S. Line

_____ Ft. from E. Line

990 Ft. from W. Line

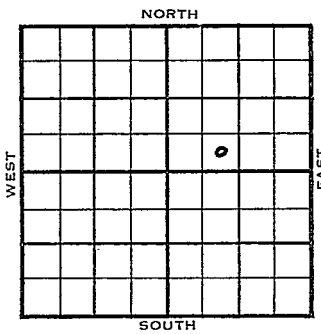

S SW NE

	ELEVATION	REPORT
1954	1759'	
6/9		Spudding 6-3-54 8"@ 178 Drlg. 2305
6/23		Spud 6-3-54 D&A TD 3300' 8" @ 178' Heeb 2721', Br lime 2840', Evans 2866', Cong 3236' DST 3201-50', opnl hr., rec. 370' mud, 330# TD 3300' D&A

ABANDONED

DX-78

FORM 275 FOR SALE BY KANSAS BLUE PRINT CO.

County Rice State Kansas

Sec. 4 (Blk. Twp.) 18 (Sur. Rge.) 8W Map No.

Operator Martin Oil (was Ash-Mar)

Well No. 5 Farm Wuthnow

Elev. Location SE SW NE



330 Ft. From S Line NE

990 Ft. From W Line Quarter

1st. Report JUN 9 1954

Completion

Remarks B.E. Ash - Contr.

Spudding Date 6-3-54

Drlg. Data Geneseo Pool

8" @ 178 drlg. 2305

J. G. McGEHEE

FORM 275 FOR SALE BY KANSAS BLUE PRINT CO.


County Rice State Kansas

Sec. 4 (Blk. Twp.) 18 (Sur. Rge.) 8W Map No.

Operator Martin Oil (was Ash-Mar)

Well No. 5 Farm Wuthnow

Elev. 1759 Location SE SW NE

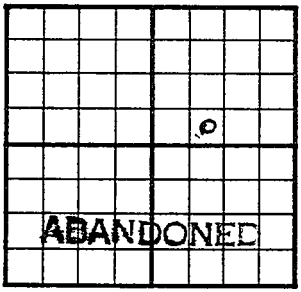

330 Ft. From S Line NE

990 Ft. From W Line Quarter

1st. Report

Completion JUN 23 1954

Remarks Geneseo Pool

B.E. Ash - Contr.

Spudding Date 6-3-54

Drlg. Data D & A TD 3300

8" @ 178 Heeb. 2721 Br. lime 2840

Lans. 2866 Cong. 3236 DST 3201-50

open 1 hr. Rec. 370' mud 330#

TD 3300

D &A

J. G. McGEHEE