

KANSAS


Rice

FORM 51 5M 10-41 PETROL

Section 8 Township 18 Range 8-W

Well No. 1 Skiles


Company Nelson Drilling

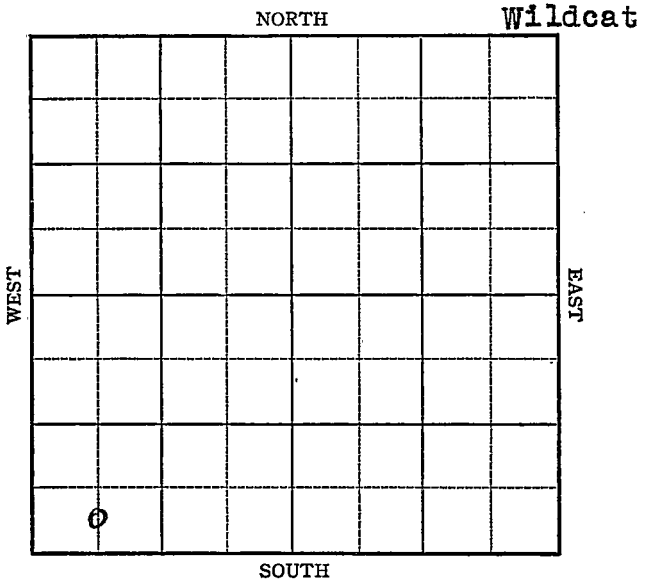

KANSAS

Map No. 45 Sec. 8 Twp. 18 R. 8 WWell No. 1 SkilesNelson Drilling CompanyFIRST REPORT ContractorC S $\frac{1}{2}$ SW SW

SECTION PLAT

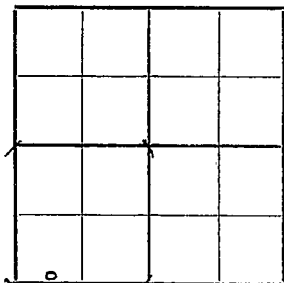 Ft. from N. Line330 Ft. from S. Line Ft. from E. Line660 Ft. from W. Line

WILDCAT

Location Rig up

Drilling and Remarks:

10" 109'

Drlg. 392'

RECORD

Cased in., ft.Sand Gas Oil Total Depth

PRODUCTION

1st 24 hrs. Nat. 1st 24 hrs. after shot Gas Cu. Ft.Dry Hole Abandoned

Date

DEC 3 1941 19S. J. LEWIS Scout

KANSAS

Rice

Map No. 45 Sec. 8 Twp. 18 R. 8WWell No. 1 SkilesNelson Drilling CompanyABANDONED ContractorC $S\frac{1}{2}$ SW SW Ft. from N. Line330 Ft. from S. Line Ft. from E. Line660 Ft. from W. Line

SECTION PLAT

WILDCAT

Location Rig up

Drilling and Remarks:

Land 2878
No show

RECORD

Cased in., ft.Sand Gas Oil Total Depth 3015

PRODUCTION

1st 24 hrs. Nat. 1st 24 hrs. after shot Gas Cu. Ft.Dry Hole Abandoned

Date

DEC 17 1941 19S. J. LEWIS Scout