


Section 9 Township 18 Range 8W

Well No. #1 Schill (A)

Company Dezier Oil

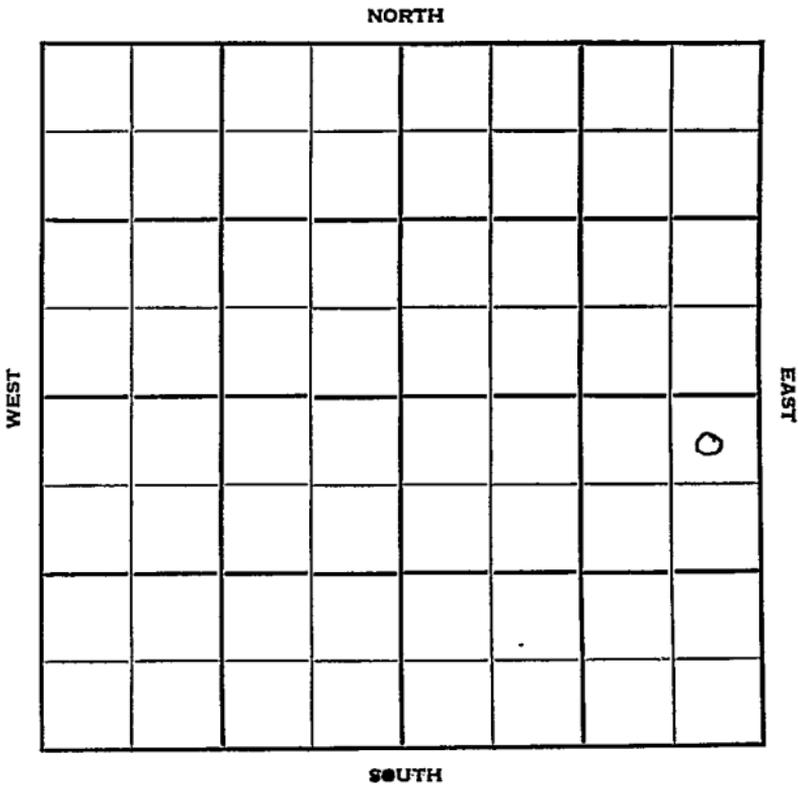

Rice

KANSAS

Sec. 9 Twp. 18 R. 8 W

Well No. # 1 Schill (A) Farm

Dozier Oil Company


Contractor

330 Ft. from N. Line

_____ Ft. from S. Line

330 Ft. from E. Line

_____ Ft. from W. Line

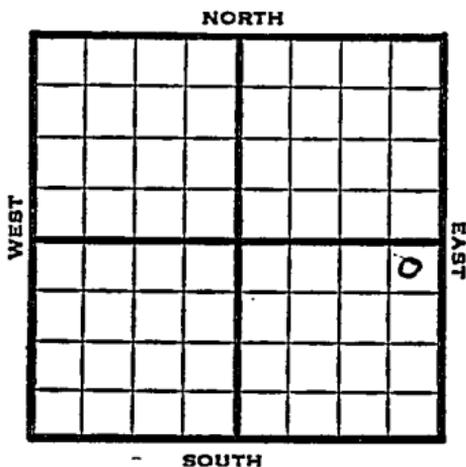

NE NE SE

1952

Elev. 1770'

REPORT

1/9
2/6

Set Surface

Spud 1-15-52

D&A TD 3288

8" @ 208'

Heeb. 2742

Brlime 2868

Lans. 2899

Cong. 3278

DST 3279-3288 open 1 hr.

rec. 930' wtr. TD 3288

D&A

ABANDONED


County Rice State Kansas

Sec. 9 (Blk. 18 (Sur. 8W (Twp.) (Rge.) Map No.

Operator Dozier Oil

Well No. 1 Farm Schill "A"

Elev. 1770 Location NE NE SE

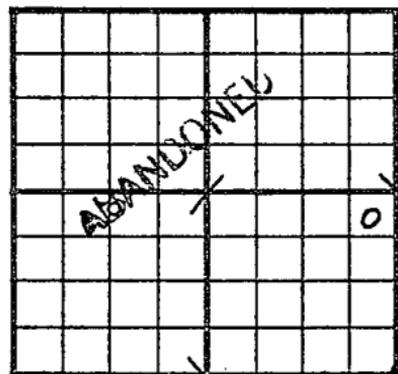

330 Ft. From N Line SE

330 Ft. From E Line Quarter

Ist. Report

Completion FEB 6 1952

Remarks

Spudding Date 1-15-52

Drlg. Data D & A TD 3288

8" @ 208 Heeb. 2742 Br. lime 2868

Lans. 2890 Cong. 3278 DST 3279-3288

open 1 hr. Rec. 930' water TD 3288

D & A