

Rice

KANSAS

Section 10 Township 18 Range 8W

Well No. #1 Dobrinski

Company J. C. Dozier

NORTH

					0	.	

WEST

EAST

SOUTH

Sec. 10 Twp. 18 R. 8W

Well No. #1 Dobrinski Farm

J. C. Dozier Company

Lewis Drlg. Contractor


\_\_\_\_\_ Ft. from N. Line

330' Ft. from S. Line

\_\_\_\_\_ Ft. from E. Line

990' Ft. from W. Line

SE SW NE

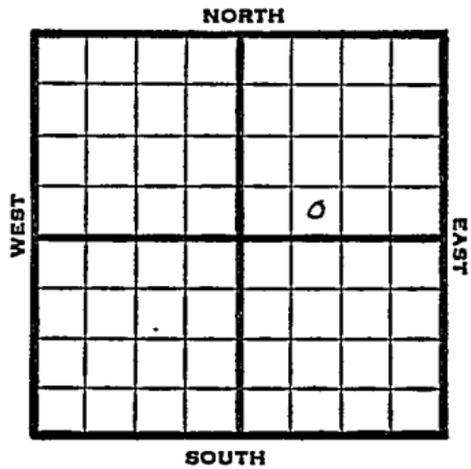

1950 Elev. 1778' REPORT

4/26 Location

6/7 8" @ 156'

Heeb 2747'

Lans. 2835'

Cong. 3256'

5" @ 3300

Simp sd 3271'

P 70 BOPD

TD 3301'

**COMPLETED**

Kansas

Map No. \_\_\_\_\_ Sec. 10 Twp. 18 R. 8WWell No. 1 DobrinskiJ. C. Dozier CompanyLewis Drlg. Contractor

SE SW NE

## SECTION PLAT

       Ft. from N. Line330 Ft. from S. Line       Ft. from E. Line990 Ft. from W. Line

Rice County

Location       X      Rig up       

Drilling and Remarks:

## RECORD

Cased        in.,        ft.Sand       Gas       Oil       Total Depth       

## PRODUCTION

1st 24 hrs. Nat.       1st 24 hrs. after shot       Gas        Cu. Ft.Dry Hole       Abandoned       

Date

APR 26 1950 19J. E. TYRA Scout

Kansas

Map No. \_\_\_\_\_ Sec. 10 Twp. 18 R. 8W

Well No. 1 Dobrinski

J. C. Dozier \_\_\_\_\_ Company

\_\_\_\_\_ Contractor

SE SW NE

E1.1778  
SECTION PLAT

\_\_\_\_\_ Ft. from N. Line

330 \_\_\_\_\_ Ft. from S. Line

\_\_\_\_\_ Ft. from E. Line

990 \_\_\_\_\_ Ft. from W. Line

COMPLETE		
		o

Rice

Location \_\_\_\_\_

Rig up \_\_\_\_\_

Drilling and Remarks:

8" @ 156

Hub 2747

Lans 2885

Cong 3256

5" @ 3300

Limp 5/3271

Date

JUN 7 1950 19

## RECORD

Cased \_\_\_\_\_ in., \_\_\_\_\_ ft.

Sand \_\_\_\_\_

Gas \_\_\_\_\_

Oil \_\_\_\_\_

Total Depth 3301

## PRODUCTION

1st 24 hrs. Nat. \_\_\_\_\_

1st 24 hrs. after shot \_\_\_\_\_

Gas \_\_\_\_\_ Cu. Ft.

Dry Hole \_\_\_\_\_

Abandoned \_\_\_\_\_

J. E. TYRA Scout