


Section 10 Township 18 Range 8 W

Well No. # 3 Dorbinski (*Dobfinski*)

Company Dozier Oil

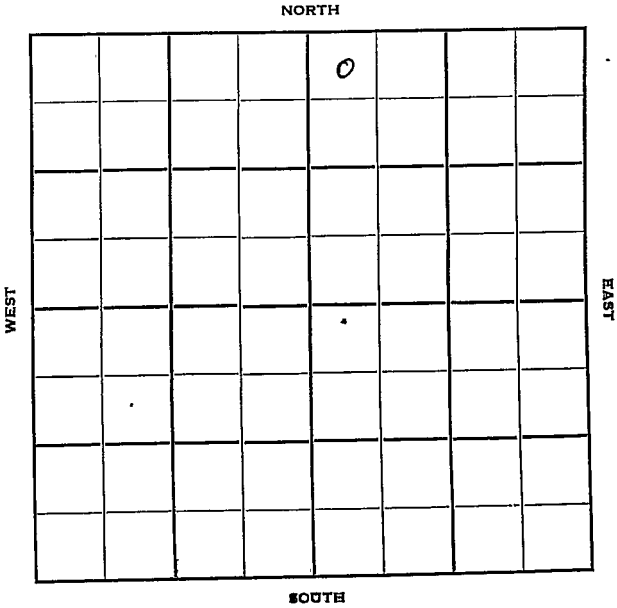

Rice

KANSAS

Sec. 10 Twp. 18 R. 8W

Well No. #3 Dobrinski Farm

Dozier Oil Company

Lewis Drlg. Contractor


330 Ft. from N. Line

\_\_\_\_\_ Ft. from S. Line

\_\_\_\_\_ Ft. from E. Line

330 Ft. from W. Line

NW NW NE

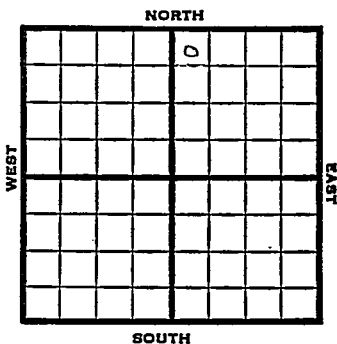

1951

Elev. 1782' REPORT

10/3 R UR

11/7 Spud 10-2-51  
 Oil Well TD 3304  
 8" @ 212  
 Heeb. 2706 Br Lime 2827  
 Lans. 2852 Simp 3211  
 Arb. 3223  
 TD 3304 5" @ 3299 11/3266-70  
 23/3254-62 10/3246-50 7/3239-42  
 2/3235-36 10/3227-35 FU 3000' oil  
 2 hr. Comp. 3000 bopd

**COMPLETED**

County **Rice** State **Kansas**

Sec. **10** (Blk. Twp.) **18** (Sur. Rge.) **8W** Map No.

Operator **Dozier Oil**

Well No. **3** Farm **Dobrinski**

Elev. Location **NW NW NE**


**FIRST REPORT**

**330** Ft. From **N** Line **NE**

**330** Ft. From **W** Line Quarter

Ist. Report **OCT 3 1951**

Completion

Remarks

**Lewis Drlg. - Contr.**

Spudding Date

Drlg. Data **Geneseo Pool**

**RUR**

