


Rice

KANSAS

Section 10 Township 18 Range 8W

Well No. #4 C. Dobrinski

Company Ash-Mar Oil

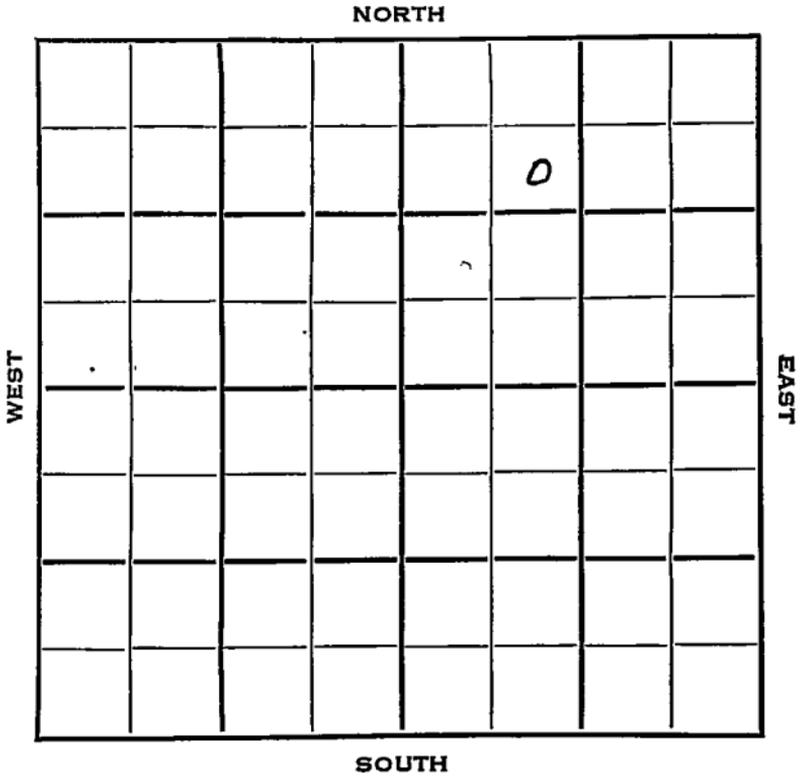

Sec. 10 Twp. _____ R. _____

Well No. #4 C. Dobrinski Farm _____

Ash-Mar Oil Company _____


Ash-Mar Contractor _____

990 Ft. from N. Line

_____ Ft. from S. Line

_____ Ft. from E. Line

990 Ft. from W. Line

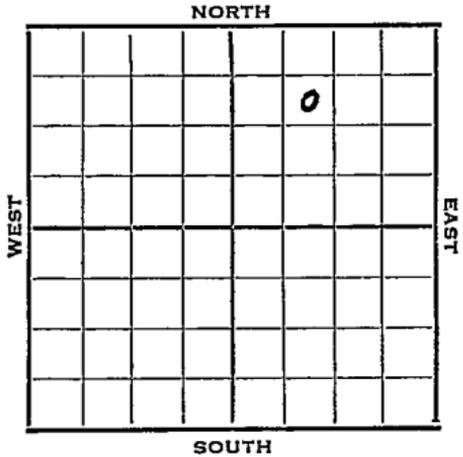

SE NW NE

1953 Elev. 1781' REPORT

2/18 Spud 2-15-53
8" @ 186, WOC

2/26 Drlg. 2813'

3/12 Br li 2839' Lans 2863 Cong 3216
SO 3230-35 Arb. 3244 RTD 3296
5" @ ~~32~~ 3296 DD 3298
FU 3000' oil 10 hrs. S/6 BOPH 10 hrs
500 A

3/19 NR

3/26 NR

4/1 Spud 2-15-53
Oil Well
TD 3298'
8" @ 186'
Br Lime 2839', Lans. 2863', Cong 3216'
SO 3230-35 Arb 3244,
TD 3296
5" @ 3296
DD 3298
FU 3000' oil 10 hr. S/ 6 boph 10 hr.
500 A
Comp. 2160 bopd 20% wtr.

COMPLETED

