
FORM 51 25M 8-50 WESTERN

Rice KANSAS

Section 10 Township 18 Range 8W

Well No. #2 Dobrinski "A"

Company Dozier Oil

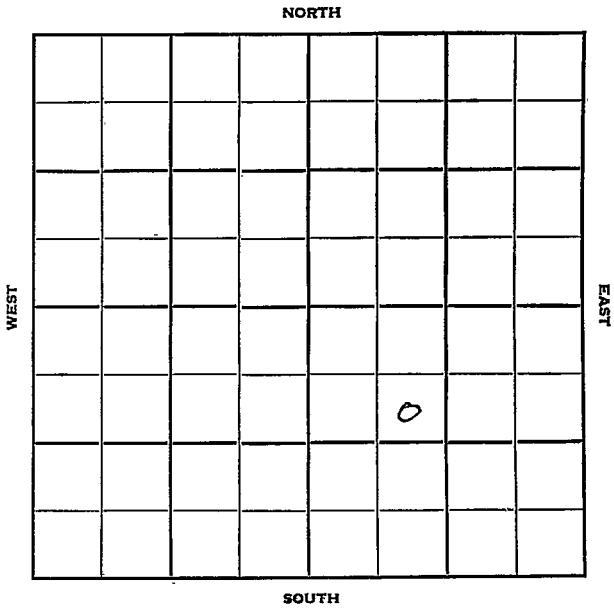

FORM 252-B
10M 9-49 PETROL

KANSAS Rice

Sec. 10 Twp. 18 R. 8-W

Well No. #2 Dobrinski "A" Farm

Dozier Oil Company

Lewis Drlg. Contractor

Geneseo


990 Ft. from N. Line

Ft. from S. Line

Ft. from E. Line

990 Ft. from W. Line

SE NW SE

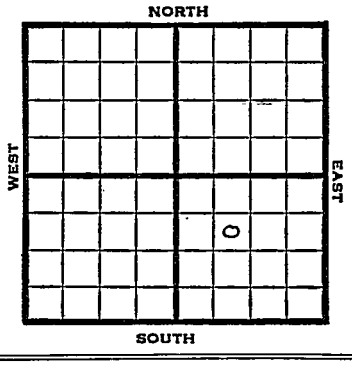

1950	Elev. 1774' REPORT
10/11	MIR
11/22	Spud 10-11-50 Oil Well TD 3264' 8" @ 147' Anhy 385' KC 2872' Congl 3240' DST 3240-64 opn 1 hr Rec. 1500' oil 5" @ 3249' Simp. 3249 TD 3264' Comp. 182 BOPD COMPLETED

FORM 275 FOR SALE BY KANSAS BLUE PRINT CO.


County Rice State Kansas

Sec. 10 (Blk. Twp.) 18 (Sur. Rge.) SW Map No.

Operator Dozier Oil

Well No. 2 Farm Dobrinski "A"

Elev. Location SE NW SE

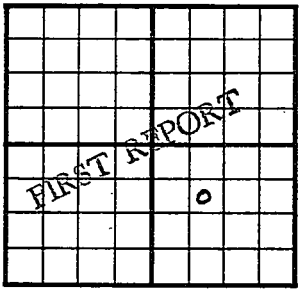

990 Ft. From N Line SW

990 Ft. From W Line Quarter

1st. Report OCT 11 1956

Completion

Remarks

Lewis Drlg. - Contr.

Spudding Date

Drlg. Data Geneseo Pool

M I R

J. E. TYRA

FORM 275 FOR SALE BY KANSAS BLUE PRINT CO.


County Rice State Kansas

Sec. 10 (Blk. Twp.) 18 (Sur. Rge.) 8W Map No.

Operator Dozier Oil

Well No. 2 Farm Dobrinski "A"

Elev. 1774 Location SE NW SE

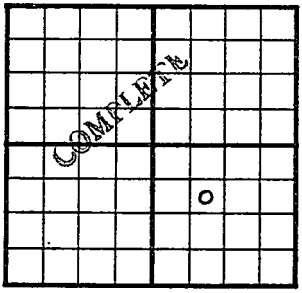

990 Ft. From N Line SW

990 Ft. From W Line Quarter

1st. Report

Completion NOV 22 1950

Remarks Geneseo Pool

Lewis Drlg. - Contr.

Spudding Date 10-11-50

Drlg. Data Oil well TD 3264

8" @ 147 Anhy 385 KC 2872 Cong. 3240

DST 3240-64 open 1 hr. Rec. 1500' oil

5" @ 3249 Simp. 3249 TD 3264

Comp. 182 bopd

J. E. TYRA