


Rice

Section 10 Township 18 Range 8-W

Well No. #1 Edna Froning

Company Dozier Oil

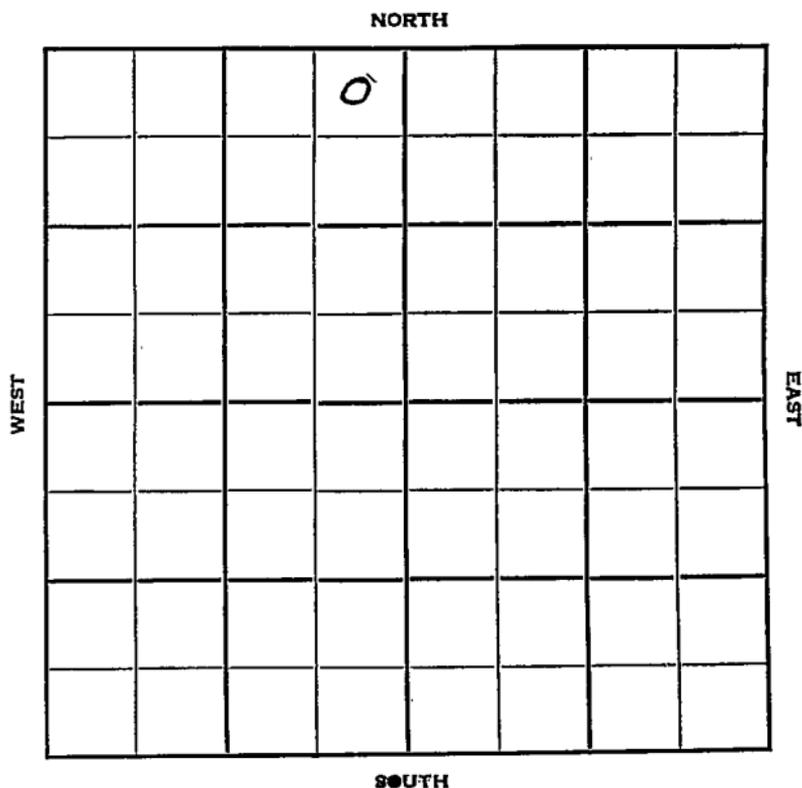

Rice

Sec. 10 Twp. 18 R. 8W

Well No. #1 Edna Froning Farm

Dozier Oil Company

Florney & Williams Contractor


Geneseo Pool

330' Ft. from N. Line

_____ Ft. from S. Line

330' Ft. from E. Line

_____ Ft. from W. Line

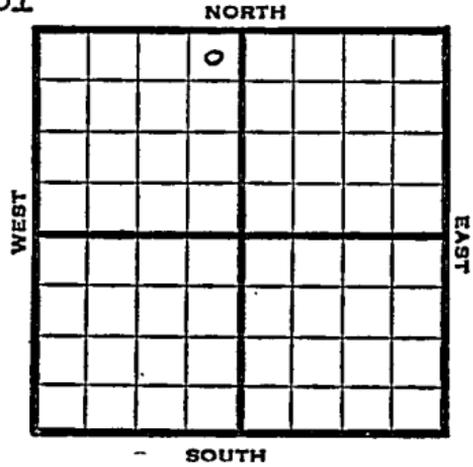

NE NE NW

1950

Elev. 1778

REPORT

11/15

Location

1951

1/31

Oil well TD 3300

8" @168

Anhy 386-405 Heeb 2709 Br. line 2831

Lans 2857 Cong. 3223 Simp. 3243

Arb. 3290-3300

5" @3290

24/3232-38 23/ 3222-30 S/ 2½ boph

Hydrofrac S/ 8 boph Dec. to 3 boph

Comp. 28 bopd

COMPLETED


County Rice State Kansas

Sec. 10 (Blk. Twp.) 18 (Sur. Rge.) 8W Map No.

Operator Dozier Oil

Well No. 1 Farm Edna Froning

Elev. _____ Location NE NE NW

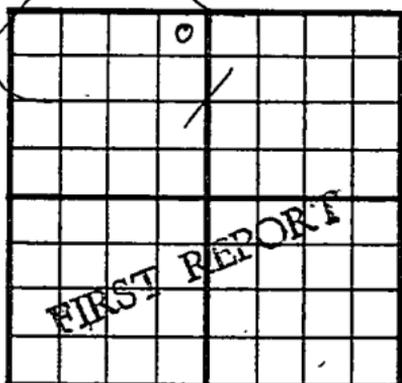

330 Ft. From N Line NW

330 Ft. From E Line Quarter

1st. Report NOV 15 1950

Completion _____

Remarks _____

Spudding Date _____

Drlg. Data Genesee Pool

Location

J. E. TYRA

