
FORM 51 25M 8-50 WESTERN Rice KANSAS

Section 10 Township 18 Range 8 W

Well No. # 2 Froning

Company Dozier Oil

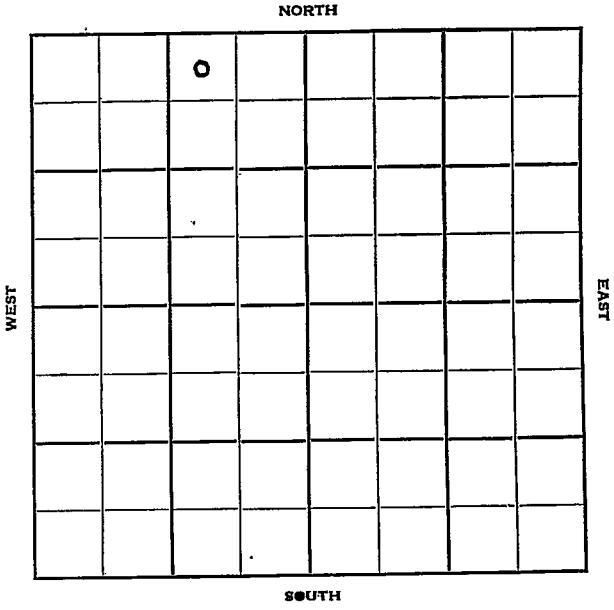

FORM 252-B
10M 11-50 PETROL

Rice

KANSAS

Sec. 10 Twp. 18 R. 8W

Well No. #2 Froning Farm

Dozier Oil Company

Stagg Drlg. - Contr. Contractor

Froning Pool


330' Ft. from N. Line

Ft. from S. Line

990' Ft. from E. Line

Ft. from W. Line

NW NE NW

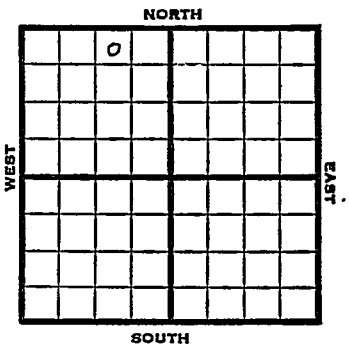

1951	Elev. 1774' REPORT
2/7	Spud 2-5-51 Drlg. 150'
3/7	Spud 2-5-51 Oil Well TD 3279 Heeb. 2709 Br lime 2832 Lans. 2858 Cong. 3228 Simp 3252' TD 3279 5" @ 3278 CO to 3255 72/3229-53 FU 1500' oil 12 hr S/27 boph Comp. 172 bopd

COMPLETED

FORM 275 FOR SALE BY KANSAS BLUE PRINT CO.


County Rice State Kansas

Sec. 10 (Blk. Twp.) 18 (Sur. Rge.) 8W Map No.

Operator Dozier Oil

Well No. 2 Farm Froning

Elev. Location NW NE NW

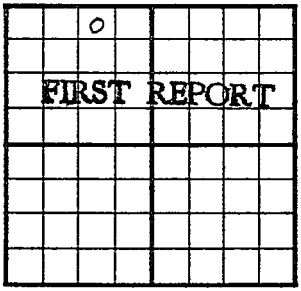

330 Ft. From N Line NW

990 Ft. From E Line Quarter

1st. Report FEB 7 1951

Completion

Remarks

Stagg Drlg. - Contr.

Spudding Date 2-5-51

Drlg. Data Froning Pool

drlg. 150

J. E. TYRA

FORM 275 FOR SALE BY KANSAS BLUE PRINT CO.


County Rice State Kansas

Sec. 10 (Blk. / Twp.) 18 (Sur. / Rge.) 8W Map No.

Operator Dozier Oil

Well No. 2 Farm Froning

Elev. 1774 Location NW NE NW

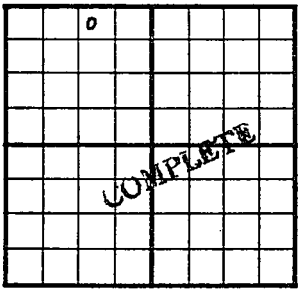

330 Ft. From N Line NW

990 Ft. From E Line Quarter

1st. Report

Completion MAR 7 1951

Remarks Froning Pool

Stagg Drlg. - Contr.

Spudding Date 2-5-51

Drlg. Data Oil well TD 3279

Heeb. 2709 Br. lime 2832 Lans. 2858

Cong. 3228 Simp. 3252 TD 3279 5" @ 3278

CO to 3255 72/ 3229-53 FU 1500' oil

12 hr. S/ 27 bopb. Comp. 172 bopd

J. E. TYRA