



Rice KANSAS


SEC.	TWP.	R.
10	18	8W ✓

WELL NO. \_\_\_\_\_  
 1 Gibson FARM

COMPANY \_\_\_\_\_  
 Ash-Mar

CONTRACTOR \_\_\_\_\_  
 Ash-Mar  
 Geneseo Pool

330 \_\_\_\_\_ Ft. from N. Line  
 \_\_\_\_\_ Ft. from S. Line  
 990 \_\_\_\_\_ Ft. from E. Line  
 \_\_\_\_\_ Ft. from W. Line

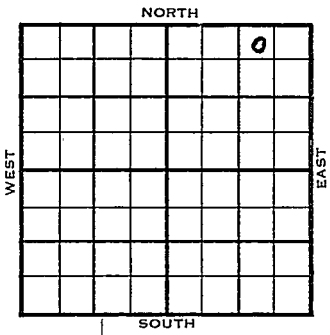

NW NE NE

1953	ELEVATION 1782'	REPORT
------	--------------------	--------

11/18 Spud 11-12-53  
 8" @ 157'  
 Anhy 585'  
 Drlg. 1673'

12/2 Spud 11-12-53  
 D&A  
 TD 3315'  
 8" @ 157'  
 Anhy 585', Heeb 2719', Br lime 2841',  
 KC 2867', Cong 3223'  
 DST 3210-70', opn 1 hr., rec. 20' mud  
 1 qt. oil, 15#  
 Simp. 3285'  
 TD 3315'  
 D&A

**ABANDONED**



