


Section 10 Township 18 Range 8WWell No. #2 GibsonCompany Francis Raymond

NORTH

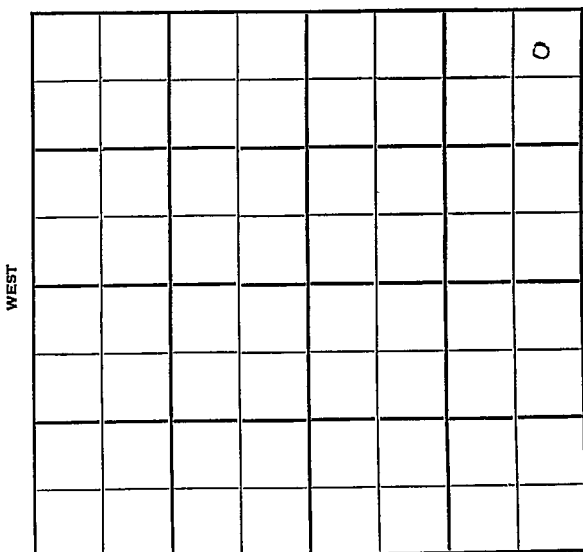

SOUTH

Rice

KANSAS

Sec. 10 Twp. 18 R. 8W

Well No. #2 Gibson Farm

Francis Raymond Company

Geneseo Pool Contractor


330' Ft. from N. Line

Ft. from S. Line

330' Ft. from E. Line

Ft. from W. Line

NE NE NE

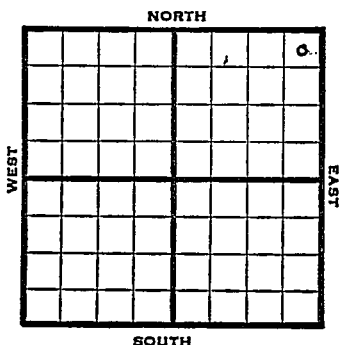

1951

Elev. 1783' REPORT

8/29 Cellar & Pits

9/19 Spud 8-28-51

D & A TD 3233' 8" @ 247'

Anhy 480-510' Heeb 2710' Br. lime

2831' Lans. 2857' Cong. 3211'

DST 3211-33 open $\frac{1}{2}$ hr. rec 6' mud

DST 3234-56 open $\frac{1}{2}$ hr. rec 4' mud

DST 3256-72 open $\frac{1}{2}$ hr. rec 30' SOCM

& 30' mud.

Arb. 3298-33' TD

D & A

ABANDONED

J. E. TYRA



J. E. TYRA