

11-9-215 

STATE CORPORATION COMMISSION OF KANSAS
OIL & GAS CONSERVATION DIVISION
WELL COMPLETION OR RECOMPLETION FORM
ACO-1 WELL HISTORY
DESCRIPTION OF WELL AND LEASE

S

API NO. 15-103-20-833
County Leavenworth
S/2 SE SW Sec. 11 Twp. 9S Rge. 21 East West

330 Ft North from Southeast Corner of Section
3300 Ft West from Southeast Corner of Section
(Note: Locate well in section plat below)


Lease Name Schwinn Well # 1

Field Name Fred Ext.

Producing Formation

Elevation: Ground 1047 KB 1052

Section Plat

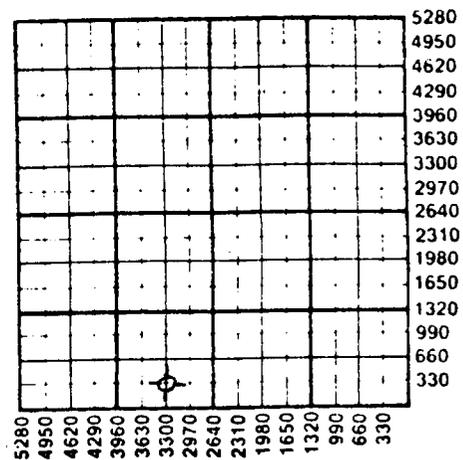

X WATER SUPPLY INFORMATION

Disposition of Produced Water: Disposal
Docket # Repressuring

Questions on this portion of the ACO-1 call:
Water Resources Board (913) 296-3717

Source of Water:
Division of Water Resources Permit #

Groundwater Ft North from Southeast Corner
(Well) Ft West from Southeast Corner of
Sec Twp Rge East West

Surface Water Ft North from Southeast Corner
(Stream, pond etc) Ft West from Southeast Corner
Sec Twp Rge East West

X Other (explain) Driller Supplied
(purchased from city, R.W.D. #)

Operator: License # 4891
Name SIMCO Exploration Company
Address P.O. Box 1515
Cheyenne, WY 82003
City/State/Zip

Purchaser None

Operator Contact Person Ted Simola
Phone 307-632-6468

Contractor: License # 5825
Name Glacier Drilling Company, Inc.

Wellsite Geologist Daniel T. Johnson
Phone 316-221-0428

Designate Type of Completion
X New Well Re-Entry Workover

Oil SWD Temp Abd
Gas Inj Delayed Comp.
X Dry Other (Core, Water Supply etc.)

If ONWO: old well info as follows:
Operator
Well Name
Comp. Date Old Total Depth

WELL HISTORY

Drilling Method:
X Mud Rotary Air Rotary Cable

4-22-87 4-24-87 4-24-87
Spud Date Date Reached TD Completion Date

1440' PBD
Total Depth

Amount of Surface Pipe Set and Cemented at 42 feet
Multiple Stage Cementing Collar Used? Yes X No

If alternate 2 completion, cement circulated
from 42 feet depth to surface 20 SX cmt
Cement Company Name Sun Cementing Inc.
Invoice #

INSTRUCTIONS: This form shall be completed in triplicate and filed with the Kansas Corporation Commission, 200 Colorado Derby Building, Wichita, Kansas 67202, within 120 days of the spud date of any well. Rule 82-3-130, 82-3-107 and 82-3-106 apply.
Information on side two of this form will be held confidential for a period of 12 months if requested in writing and submitted with the form. See rule 82-3-107 for confidentiality in excess of 12 months.
One copy of all wireline logs and drillers time log shall be attached with this form. Submit CP-4 form with all plugged wells. Submit CP-111 form with all temporarily abandoned wells.