

API NO. 15-.....103-20,474.....

County...Leavenworth.....
 SE NE.. NE.. Sec 14... Twp 9.... Rge. 21... X East
 West

..42.90..... Ft North from Southeast Corner of Section
165..... Ft West from Southeast Corner of Section
 (Note: Locate well in section plat below)


Lease Name..Becker.....Well #..1.....

Field Name.....

Producing Formation... Burgess.....

Elevation: Ground.....1090.....KB.....1094.....
Section Plat

Section Plat

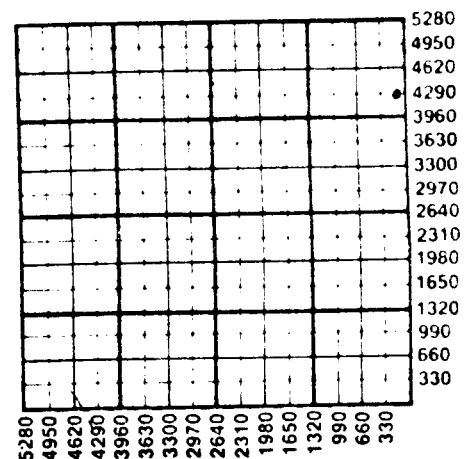

APR 15 1988

WATER SUPPLY INFORMATION

Disposition of Produced Water: _____ Disposal
Docket # Repressuring

Questions on this portion of the ACO-1 call:

Water Resources Board (913) 296-3717

Source of Water:
Division of Water Resources Permit #.....NA.....

Groundwater.....Ft North from Southeast Corner
(Well)Ft West from Southeast Corner of
Sec Twp Rge East West

Surface Water.....Ft North from Southeast Corner
(Stream,pond etc).....Ft West from Southeast Corner

Sec	Twp	Roe	East	West
-----	-----	-----	------	------

x Other (explain) Salt Water
(purchased from city, R.W.D. #)

INSTRUCTIONS: This form shall be completed in duplicate and filed with the Kansas Corporation Commission, 200 Colorado Derby Building, Wichita, Kansas 67202, within 90 days after completion or recompletion of any well. Rule 82-3-130 and 82-3-107 apply.

Information on side two of this form will be held confidential for a period of 12 months if requested in writing and submitted with the form. See rule 82-3-107 for confidentiality in excess of 12 months.

One copy of all wireline logs and drillers time log shall be attached with this form. Submit CP-4 form with all plugged wells. Submit CP-111 form with all temporarily abandoned wells.

35-P-44

All requirements of the statutes, rules and regulations promulgated to regulate the oil and gas industry have been fully complied with and the statements herein are complete and correct to the best of my knowledge.

Signature *Fred C. Berckefeldt*.....

Fred C. Berckefeldt

Title *President*..... Date *4/11/86*.....

President

Subscribed and sworn to before me this *11* day of *April*.....

19*86*.

Notary Public *Deborah E. Berckefeldt*.....

Deborah E. Berckefeldt

Date Commission Expires *6-22-86*.....

STATE CORPORATION COMMISSION

APR 15 1986

CONSERVATION DIVISION
Wichita, Kansas

K.C.C. OFFICE USE ONLY

F ☐ Letter of Confidentiality Attached

C ☒ Wireline Log Received

C ☐ Drillers Timelog Received

Distribution

☒ KCC ☐ SWD/Rep ☐ NGPA
☒ KGS ☐ Plug ☐ Other
(Specify)

Form ACO-1 (7-84)

Sec 14 Two 9 31E

14-9-21E

SIDE TWO

Operator Name red C. Berckefeldt Lease Name Becker Well # 1

Sec. 14 Twp. 9 Rge. 21 ☒ East ☐ West County Leavenworth

WELL LOG

INSTRUCTIONS: Show important tops and base of formations penetrated. Detail all cores. Report all drill stem tests giving interval tested, time tool open and closed, flowing and shut-in pressures, whether shut-in pressure reached static level, hydrostatic pressures, bottom hole temperature, fluid recovery, and flow rates if gas to surface during test. Attach extra sheet if more space is needed. Attach copy of log.

Drill Stem Tests Taken ☐ Yes ☒ No
Samples Sent to Geological Survey ☐ Yes ☒ No
Cores Taken ☐ Yes ☒ No

Formation Description
☒ Log ☐ Sample

Name	Top	Bottom
Cattleman	1258	1282
Top of Miss.	1434	

Dry & Abandoned - Plugging Report Filed

APR 15 1986

CASING RECORD ☐ New ☒ Used							
Report all strings set-conductor, surface, intermediate, production, etc.							
Purpose of String	Size Hole Drilled	Size Casing Set (In O.D.)	Weight Lbs/Ft.	Setting Depth	Type of Cement	#Sacks Used	Type and Percent Additives
surface	9 7/8	7"	15.50	45	Portland	57	3% Cal
PERFORATION RECORD				Acid, Fracture, Shot, Cement Squeeze Record			
Shots Per Foot Specify Footage of Each Interval Perforated				(Amount and Kind of Material Used) Depth			
TUBING RECORD				Liner Run ☐ Yes ☐ No			
Size Set At Packer at							
of First Production				Producing Method			
				☐ Flowing ☐ Pumping ☐ Gas Lift ☐ Other (explain).....			

315-P-41

Estimated Production Per 24 Hours	Oil	Gas	Water	Gas-Oil Ratio	Gravity
	Bbls	MCF	Bbls	CFPB	

METHOD OF COMPLETION

Production Interval

Disposition of gas: ☐ Vented
☐ Sold
☐ Used on Lease

☐ Open Hole ☐ Perforation
☐ Other (Specify)

.....

☐ Dually Completed
☐ Commingled

.....

DEA