

State Kansas County Barber


Company Gulf Oil Corp. Well No. 13

Farm W. A. Newkirk

Survey _____

Block No. _____ Sec. 17 Twp. 33^s Range 11^w

Co-Ord. _____ Elev. _____

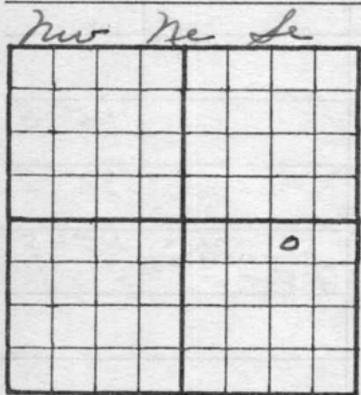

100% = Gulf Oil Corp
(Not necessary to call)

NOTE: Show Sketch of Lease and Well Location in Above Space

Ft. from N. Line 2310 Ft. from S. Line _____

Ft. from W. Line 990 Ft. from E. Line _____

Date	Depth	
		<u>Spd 3-11-55</u>
<u>3-10</u>		<u>M L R J.</u>
<u>3-11</u>		<u>R U R J.</u>
<u>3-12</u>		<u>8 5/8" @ 210' w/200 st cew,</u> <u>4 cc. P.O. 11 pm 3-11</u>
<u>3-13</u>	<u>777</u>	<u>Dreg. S.U.S. 1:40 am</u>
<u>3-14</u>	<u>1907</u>	<u>Dreg (3/4° off @ 1656')</u>
<u>3-15</u>	<u>2387</u>	<u>Dreg (3/4° off @ 2137')</u>
<u>3-16</u>	<u>2907</u>	<u>Dreg</u>
<u>3-17</u>	<u>3366</u>	<u>Dreg (1° off @ 3170')</u>

Date	Depth	716079
3-18	3695 3759	Douglas Ad Dreg
3-19	3974	Dreg
3-21	4290	Dreg
3-22	4398	Dreg
3-23	4465	Miss.
	4504	Coring (1 1/4" off @ 4345')
3-24	4544	Coming out w/ core barrel (Had been jammed)
3-25	4600	R.T.D. Mill circ 2 then lay down drill pipe for
3-26	4597	5' TO running 5 1/2" on bottom @ 4597' w/ 225 ft com. Stopped 17' off bottom
		546' cement in pipe. To run & then + drill out
3-27	P.O. 12:10 am D-26	5 1/2" @ 4583 (Optim. mem.) w/ 275 ft com. Dred 103 cem; raw @ 4009
3-28		Dred cement @ 4383'
3-29		Drilled out cement. Pulled 2 bgs. Compl. 3-29-55
		MICT
3-30		DOC to 4542. No. Log truck
3-31		Perf. 4510-4530 w/ 4 5/8". Testing Going to run tbg and frac
4-1		Frack w/ 9000 ⁺ gal, 9000 gals free air, 400 gals mud acid. 3l load back
4-2		2l @ 80 PH, 40% wtc
4-3		7l @ 80 PH, 35% wtc
4-4		2l @ 3 1/2 BPPH, 30% wtc. To run rods today

State Kansas County Barber


Company Guy Oil Corp Well No. 13

Farm H. A. Newkirk

Survey _____

Block No. _____ Sec. 17 Twp. 33^S Range 11^W

Co-Ord. _____ Elev. _____

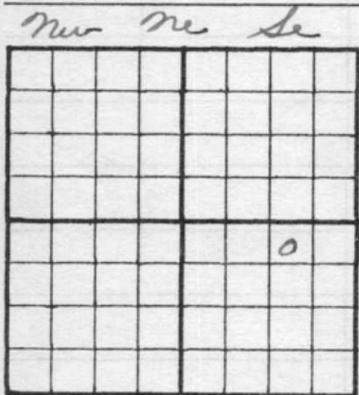

Rig #4
C. J. U. 2

NOTE: Show Sketch of Lease and Well Location in Above Space

Ft. from N. Line _____ Ft. from S. Line _____

Ft. from W. Line _____ Ft. from E. Line _____

Date	Depth	
<u>4-5-55</u>	<u>Swb 4-5 BFPH, 30% into</u>	
	<u>Compl 4-5-55</u>	
	<u>(Received orders) about 8 am</u>	
	<u>to tear down)</u>	