

State Kansas County Barber

Company Wm. Graham Oil Co. Well No. 1

Farm H. U. Magnison


Survey _____

Block No. _____ Sec. 3 Twp. 33S Range 13W

Co-Ord. _____ Elev. 1690 KB

C NW SE

Rig #3

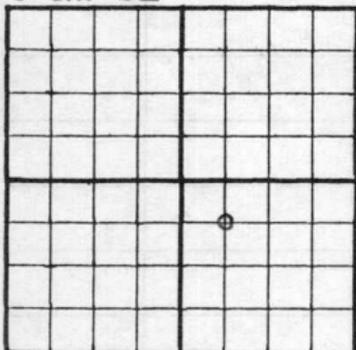

100% Wm Graham Oil Co.

Cities Service Farmout
AM 5-5621

3950' Test

NOTE: Show Sketch of Lease and Well Location in Above Space

660 Ft. from N. Line Ft. from S. Line

660 Ft. from W. Line Ft. from E. Line

Date	Depth	
		MIRT 8-7-54
8-9		8 5/8" @ 280' w/175 sx cem, 3 gel, 5 C.C. P.D. 9 a.m. 8-8-54
	500	Drlg
8-10	1915	Drlg
8-11	2325	Drlg
8-12	2705	Drlg
8-13	3170	Drlg
8-14	3520	Drlg
8-15	3651	Elgin Sd

