

State

Kansas

County

Barber

Company

Leaw Oil Co. (Div. of  
Monaco Chemical Co.)

Well No.

1

Farm

Vestal

Survey

Block No.

Sec.

116

Twp.

34

Range


12

Co-Ord. C. P. 3475 A. P. 3550

Elev. 1482 KB

C. Sec. SW SW

Rig #2

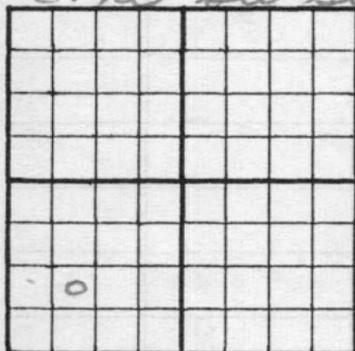

100% Leaw Oil Co.  
(Division of  
Monaco Chemical Co.)

10' 3300-3550 5' 3550-70.

NOTE: Show Sketch of Lease and Well Location in Above Space

Ft. from N. Line

990

Ft. from S. Line

990

Ft. from W. Line

Ft. from E. Line

Date	Depth	
		Spd 1-25-56
1-24-56		Moving rig. Truck stopped yesterday because of road condition
1-25	43	Dreg (Spd 5:40 a.m.)
1-26		8 5/8" @ 355' w/275# foamite, 5cc, 2 gal. P.O. 2:30pm 1-25. W.O.C.
1-27	1570	Dreg (1/2° off. 1488)
1-28	2310	Dreg
1-29	2959	Dreg

7/6/22

Date	Depth	
1-30	3452	Dreg (1/4° @ 3230)
1-31	3810	Dreg (3/4° @ 3740)
2-1	4124	making trip.
2-2	4328	Dreg
2-3	4481	making lit trip.
2-4	4625	Dreg. (1° off @ 4576')
2-6	D.S.J. #1	- 4683-4724 - Op. 1 hr, Cl. 20" Gas to surf. in 10" rev. 40' GCM - I.F.P. 70# F.F.P. 70#, B.H.P. 1350#
	D.S.J. #2	4728-4760' - Op. 44" cl. 20" Rev. 15' mud, I.F.P. 10# I.F.P. 10#, B.H.P. 15#
	4697	Mississippi (-3215) Circulating @ 4800' Getting ready to log & run pipe
	4800	R.T.D.
2-7		5 1/2 @ <sup>4776</sup> 4790' (24' off bottom) w/150 ml permix. P.D. @ 6:15 a.m. <sup>2/7</sup>
2-11	m.c.c.	
2-13		Sailing every 2 hrs. Getting 1 qt water w/ show oil.

