

Section 11 Township 18 Range 8W

Well No. #3 Godschaft

Company Virginia Drlg.

NORTH

|  |   |  |  |  |  |  |  |
|--|---|--|--|--|--|--|--|
|  |   |  |  |  |  |  |  |
|  |   |  |  |  |  |  |  |
|  |   |  |  |  |  |  |  |
|  |   |  |  |  |  |  |  |
|  |   |  |  |  |  |  |  |
|  | 6 |  |  |  |  |  |  |
|  |   |  |  |  |  |  |  |
|  |   |  |  |  |  |  |  |

WEST

EAST

SOUTH

Rice

KANSAS

8W ✓

Sec. 11 Twp. 18 R. \_\_\_\_\_

Well No. #3 Godschalt Farm \_\_\_\_\_

Virginia Drlg. Company \_\_\_\_\_

Virginia Drlg. - Contr. Contractor \_\_\_\_\_

Geneseo Pool


990' Ft. from N. Line

\_\_\_\_\_ Ft. from S. Line

\_\_\_\_\_ Ft. from E. Line

990' Ft. from W. Line

SE NW SW

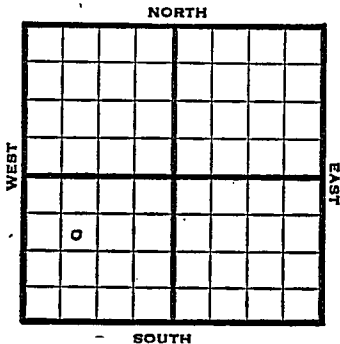

1950 Elev. 1774' REPORT

11/22 Set surface

1951

2/14 Spud 11-19-50  
Oil Well TD 3950  
8" @ 250' Anhy 475'  
Heeb. 2718' Dodge 2740  
Br Line 2845' Lans. 2873'  
Cong. 3233' Gh Cong. 3243  
DST 3245-65 opn 1 hr Rec. 1150'  
fluid 740' was wtr 410' oil  
DST 3275-90 opn 15 min  
Rec. 1150' sw ReArb 3314-58  
Arb. 3405' TD 3950  
5" @ 3950 13/3255-60 S/5 boph  
25% wtr Comp. 30 bopd 20% wtr.

**COMPLETED**



