


KANSAS Rice County

Section 11 Township 18 Range 8W

Well No. #1 Lyons Bldg. & Loan

Company Herndon Drlg.

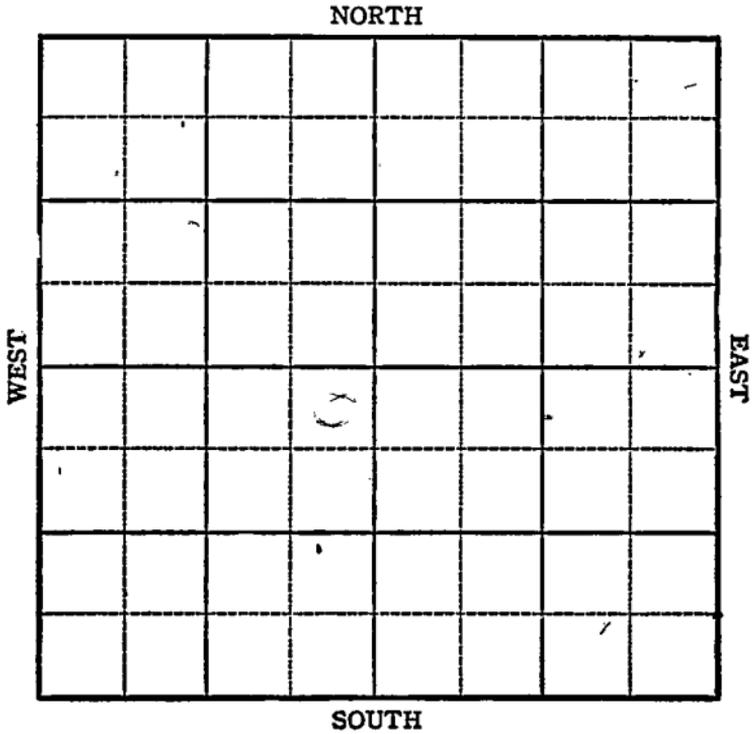

Sec. 11 Twp. 18 R. 8W

Well No. #1 Lyons Bldg. & Loan Farm

Herndon Drlg. Company


Geneseo

330 Ft. from N. Line

_____ Ft. from S. Line

330 Ft. from E. Line

_____ Ft. from W. Line

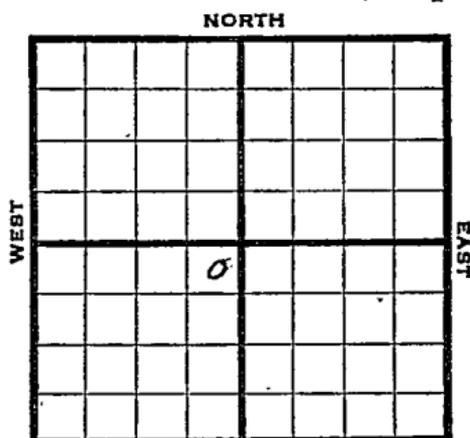

NE SW *Elev. 1773*

1944

R E P O R T

11/15

Location

11/24

8" @ 235 W O C

11/29

Drlg. 2250

12/6

Lans 2834'

Arb. 3258-3261 TD

5" @ 3260'

RUST

12/14

" " " " "

12/21

" " " " "

2/29

" " " " "

1945

1/3

TD 3268 CO

1/10

TD 3271 SO 1000 acid

1/17

Swb 27 oil per hr

1/26

" " " " "

1/31

" " " " "

2/7

" " " " "

2/14

" " " " "

2/21

" " " " "

2/28

" " " " "

OVER

1945

3/7 Arb 3258
5" @ 3260 1000 acid.
TD 3271
Pump 265 Pot.
Grav. 39.0

COMPLETED

Pool Name Gene seo

Map No. 45 Sed 1 Twp. 18 R. 8W

Well No. 1 Lyons Blg & Loan

Herndon Drig. Company

FIRST REPORT

Contractor

NE SW

SECTION PLAT

330 Ft. from N. Line

_____ Ft. from S. Line

330 Ft. from E. Line

_____ Ft. from W. Line

		o	

Rice County

Location X

Rig up _____

Drilling and Remarks:

RECORD

Cased _____ in., _____ ft.

Sand _____

Gas _____

Oil _____

Total Depth _____

PRODUCTION

1st 24 hrs. Nat. _____

1st 24 hrs. after shot _____

Gas _____ Cu. Ft.

Dry Hole _____

Abandoned _____

Date

NOV 15 1944 19

S. J. LEWIS Scout

Pool Name Geneseo

Map No. 45 Sec. 11 Twp. 18 R. 8W

Well No. 1 Lyons Bldg & Loan

Herndon Drlg. Company

COMPLETED Contractor

NE SW


SECTION PLAT

330 Ft. from N. Line

_____ Ft. from S. Line

330 Ft. from E. Line

_____ Ft. from W. Line

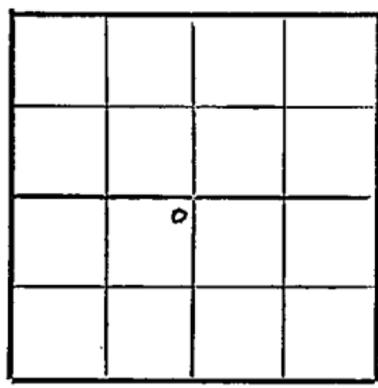

Rice County

Location _____

Rig up _____

Drilling and Remarks:

*Core 3258
5' @ 3260
1000 acid
Pump 265 P & X*

39° 42'

RECORD

Cased _____ in., _____ ft.

Sand _____

Gas _____

Oil _____

Total Depth 3271

PRODUCTION

1st 24 hrs. Nat. _____

1st 24 hrs. after shot _____

Gas _____ Cu. Ft.

Dry Hole _____

Abandoned _____

Date

MAR 7 1945 19

S. J. LEWIS

Scout