


Section 10 Township 18 Range 8W

Well No. #3 Gibson

Company Herndon Drlg.

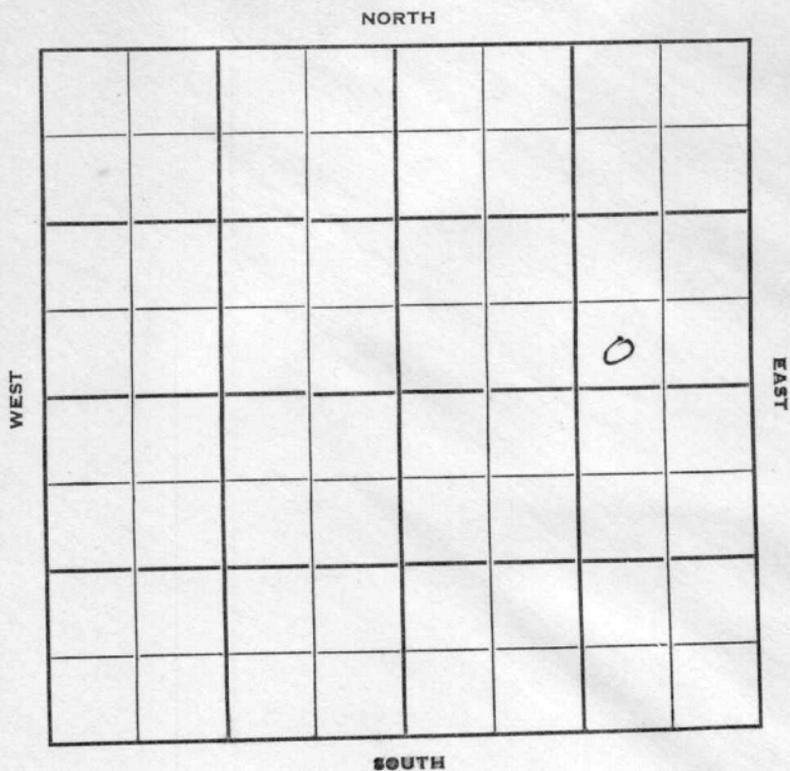

Rice
18

KANSAS

Sec. 10 Twp. _____ R. 8W

Well No. #3 Gibson Farm _____

Herndon Drlg. Company _____

Herndon Contractor _____
Geneseo Pool

_____ Ft. from N. Line


330'

_____ Ft. from S. Line

990'

_____ Ft. from E. Line

_____ Ft. from W. Line

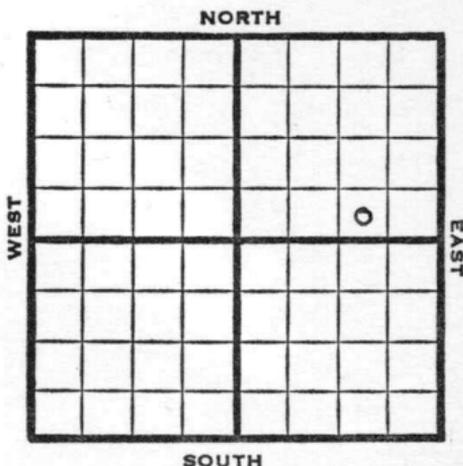

SW SE NE

1950

Elev 1779

REPORT

9/13

Spud 9-9-50

8" @ 245'

Drlg. 2300'

10/4

8" @ 245

Simp 3264

TD 3275

5" @ 3265

500 A

FU 65' fluid 60' water

D&A

ABANDONED

County Rice State Kansas

Sec. 10 (Blk. 18) (Sur. 8W) (Twp.) (Rge.) Map No.

Operator Herndon Drlg.

Well No. 3 Farm Gibson

Elev. _____ Location SW SE NE

330 Ft. From S Line NE

990 Ft. From E Line Quarter

1st. Report SEP 13 1950

Completion _____

Remarks _____

Spudding Date 9-9-50

Drlg. Data Geneseo Pool

8" @ 245 drlg. 2300

