


Rice

Section 11 Township 18 Range 8-W

Well No. 2 Batterton

Company Cities Service Oil

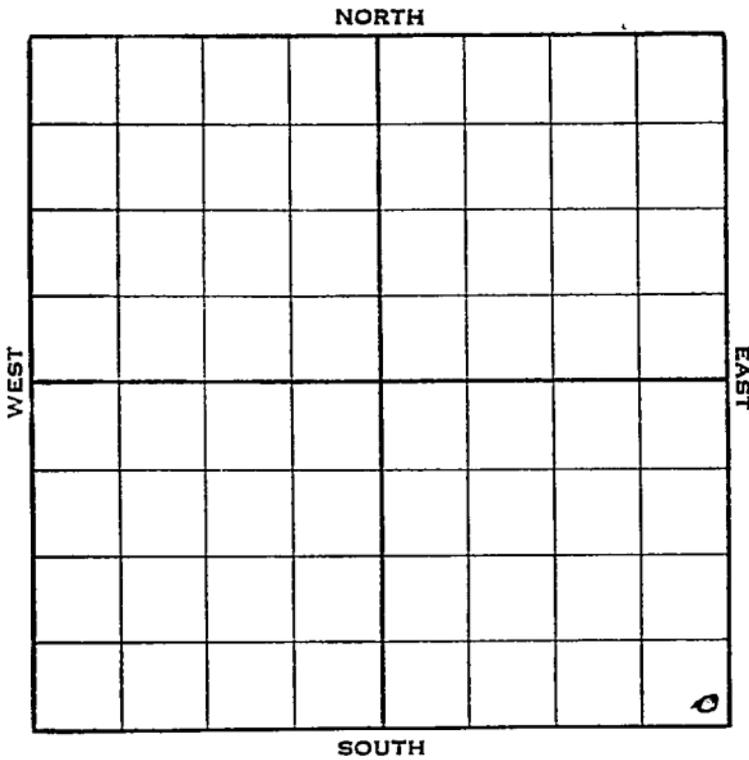

KANSAS

Rice

Sec. 11 Twp. 18 R. 8-W

Well No. #2 Batterton Farm


Cities Service Oil Company

_____ Ft. from N. Line

330 Ft. from S. Line

330 Ft. from E. Line

_____ Ft. from W. Line

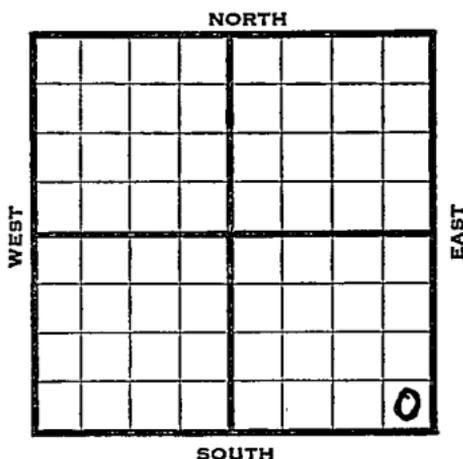

Elev. 1755'

1938	REPORT
6/15	B.R.R.
6/24	16" @ 210'. WOG.
7/1	Drlg. 3152'
7/8	Arb. @ 3207'. T. D. 3218'. S. O. 7" - 3209'.
7/15	Arb. 3211'. 7" - 3213' (Corrected) T. D. 3245'. 2350' oil.
7/20	7" - 3213'. Arb. 3211'. T. D. 3245'. 4000 acid. Potential 729 bbls.
COMPLETED	

Map No. 45 Sec. 11 Twp. 18 R. 8WWell No. 2 BattertonCities Service Oil Company

Contractor

FIRST REPORT
SE/C

_____ Ft. from N. Line

330 Ft. from S. Line330 Ft. from E. Line

_____ Ft. from W. Line

SECTION PLAT

			0

Location _____

Rig up _____

Drilling and Remarks:
BRR

RECORD

Cased _____ in., _____ ft.

Sand _____

Gas _____

Oil _____

Total Depth _____

PRODUCTION

1st 24 hrs. Nat. _____

1st 24 hrs. after shot _____

Gas _____ Cu. Ft.

Dry Hole _____

Abandoned _____

Date

JUN 15 1938 19 H. D. Hatfield Scout

Map No. 45 Sec. 11 Twp. 18 R. 8WWell No. 2 BattertonCities Service Oil Company

Contractor

COMPLETED

SE/C

SECTION PLAT

			0

_____ Ft. from N. Line

330 Ft. from S. Line330 Ft. from E. Line

_____ Ft. from W. Line

Location _____

Rig up _____

Drilling and Remarks:

4000 acidPOT 729

RECORD

Cased 7 in. 3213 ft.Sand Arb 3211.52

Gas _____

Oil _____

Total Depth 3245

PRODUCTION

1st 24 hrs. Nat. _____

1st 24 hrs. after shot _____

Gas _____ Cu. Ft.

Dry Hole _____

Abandoned _____

Date

JUL 20 1938 19 _____

H. D. Hatfield

Scout