

Rice

KANSAS

Sec. 11 Twp. 18 R. 8W

Well No. #4 Batterton Farm

Cities Service Company

Holme Drlg. - Contr. Contractor

Geneseo Pool


Ft. from N. Line

275' Ft. from S. Line

1045' Ft. from E. Line

Ft. from W. Line

SW SE SE

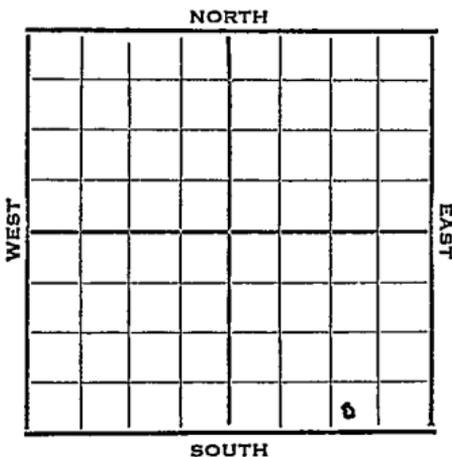

1951 Elev. 1741' REPORT

12/12 Spud 12-7-51
8" @ 242
Drlg. 1690'

1952
1/30 Spud 12-7-51
Oil Well TD 3225
8" @ 242
Lans. 2804 Cong. 3156
ReArb. 3203 Arb. 3211
TD 3215 5" @ 3212 DD 3225
500 A P/ 92 bopd
Comp. 83 bopd

COMPLETED

