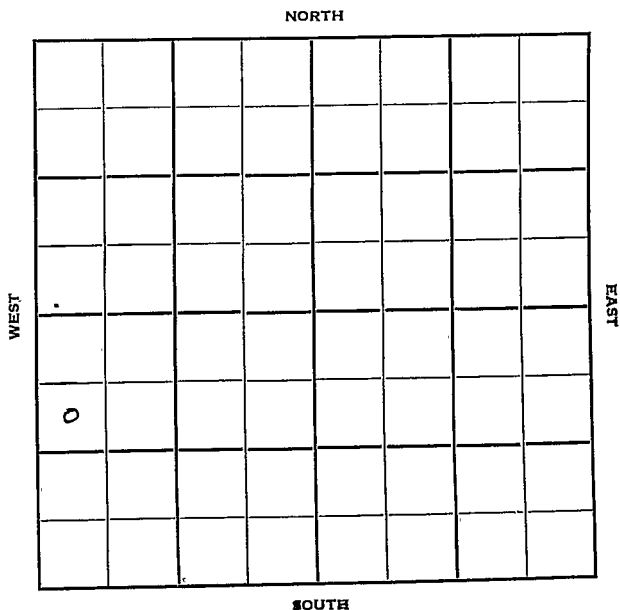


Section 11 Township 18 Range 8-WWell No. #1 GodschaltCompany Virigina Drlg.

Rice

18

8W

Sec. 11 Twp. 18 R. 8W

Well No. #1 Godschalt Farm

Virginia Drlg. Company

Virginia Drlg. & Contr. Contractor

Geneseo Pool

990' Ft. from N. Line


NORTH

Ft. from S. Line

Ft. from E. Line

330' Ft. from W. Line

SW NW SW

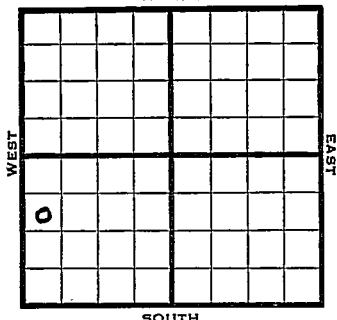

1950

Elev. 1776' REPORT

8/16


8" @ 142'
Drlg. 1245'
8-12-50 Spud

11/8

Spud 8-12-60
Oil Well TD 3258'
8" @ 242' Anhy 450'
DST 2886-99 opn 40 min
Rec. 50' mud Lans. 2875' Cong. 3238'
TD 3257'
DST 3246-57 opn 1 hr
Rec. 1500' hvy gas cut oil
5½" @ 3257' Cong. 3257'
DD 3258' FU 1400' oil 45min
Comp. 182 BOPD 32% wtr.

COMPLETED

J. E. TYRA

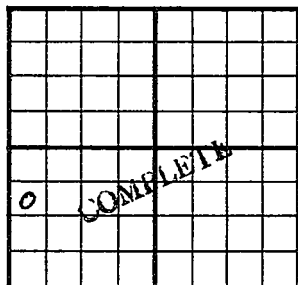County Rice State KansasSec. 11 (Blk. 18) (Sur. 8W) Map No. 8WOperator Virginia Drlg.Well No. 1 Farm GodschaltElev. 1776 Location SW NW SW990 Ft. From N Line SW330 Ft. From W Line Quarter1st. Report Completion NOV 8 '50Remarks Geneseo PoolVirginia Drlg. - Contr.Spudding Date 8-12-50Drlg. Data Oil well TD 32588" @ 242 Anhy 450 DST 2886-99 open 40min. Rec. 50' mud Lans. 2875 Cong. 3238TD 3257 DST 3246-57 open 1 hr. Rec.1500' hvy gas cut oil 5 $\frac{1}{2}$ " @ 3257Cong. 3257 DD 3258 FU 1400' oil 45 min.Comp. 182 bopd 32% water