


State Kansas County Edwards  
 Company Natural Gas Corp Well No. 3  
 Farm Hahn  
 Survey \_\_\_\_\_

Block No. \_\_\_\_\_ Sec. 4 Twp. 24 S Range 16 W  
 Co-Ord. \_\_\_\_\_ Elev. \_\_\_\_\_

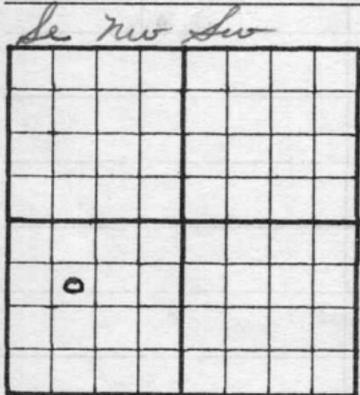

*Lig # 3*

*100% Natural Gas Corp.  
 FO 30208*

*Not nec to call*

NOTE: Show Sketch of Lease and Well Location in Above Space

Ft. from N. Line 1650 Ft. from S. Line \_\_\_\_\_  
990 Ft. from W. Line \_\_\_\_\_ Ft. from E. Line \_\_\_\_\_

Date	Depth	
		<i>Spd 3-2-55</i>
<i>3-1</i>		<i>Have dug pits. N.O. release from Nat Gas Co.</i>
<i>3-2</i>		<i>Had tire tble - didn't get moved</i>
<i>3-3</i>		<i>10 3/4" @ 217' w/175 sq cem, 2% gel, 4cc. P.O. 9:10 pm 3-2</i>
<i>3-4</i>	<i>1204</i>	<i>Dreg (1/2" off @ 1000)</i>
<i>3-5</i>	<i>2160</i>	<i>Dreg (1 1/2" off @ 1877)</i>
<i>3-7</i>	<i>3040</i>	<i>Dreg</i>

