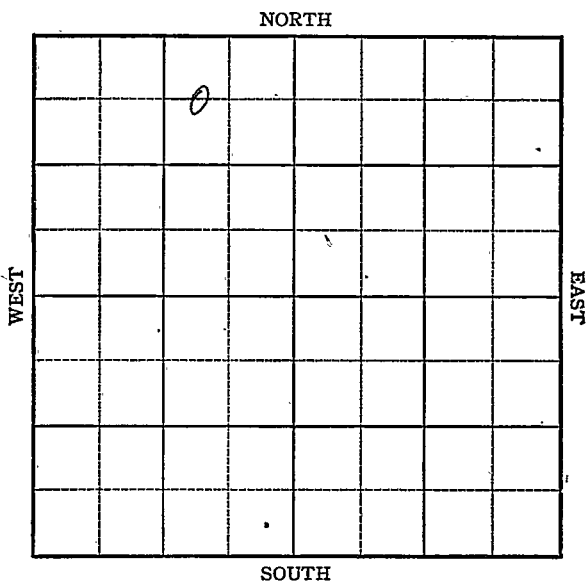


Rice KANSAS

Section 11 Township 18 Range 8WWell No. #6 RossCompany Cities Service
Genesee Pool

Rice

KANSAS

Sec. 11 Twp. 18 R. 8W

Well No. #6 Ross Farm

Cities Service Company

Geneseo Pool


660' Ft. from N. Line

Ft. from S. Line

990' Ft. from E. Line

Ft. from W. Line

C W L NE NW

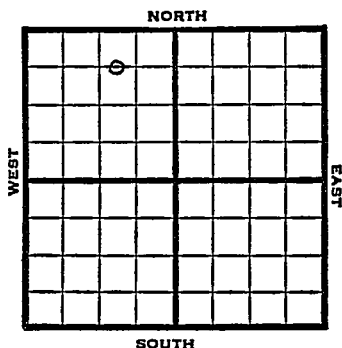

1949 Elev 1770' REPORT

12/14 Location

12/21 10" @ 295'

Drlg 2310'

12/28 Dglg 3230'

1950

2/8

TD 3262'

10" @ 295'

5" @ 3261'

Eans 2841'

Gong 3219'

Arb. 3260'

P 124 BO 14 hrs.

Comp for 1189 BOPD

No wtr.

Comp

COMPLETED

Kansas

Map No. _____ Sec. 11 Twp. 18 R. 8WWell No. 6 Ross

_____ Cities Service _____ Company

_____ Contractor

C W L NE NW

FIRST REPORT
SECTION PLAT660 Ft. from N. Line

_____ Ft. from S. Line

990 Ft. from E. Line

_____ Ft. from W. Line

	o		

Rice County

Location XRig up 3:30

Drilling and Remarks:

RECORD

Cased _____ in., _____ ft.

Sand _____

Gas _____

Oil _____

Total Depth _____

PRODUCTION

1st 24 hrs. Nat. _____

1st 24 hrs. after shot _____

Gas _____ Cu. Ft.

Dry Hole _____

Abandoned _____

Date

DEC 14 1949 19 S. J. LEWIS Scout

Map No. _____ Sec. 11 Twp. 18 R. 8WWell No. 6 Ross

_____ Cities Service _____ Company

_____ Contractor

C W L NE NW

E. 1770
SECTION PLAT660

_____ Ft. from N. Line

_____ Ft. from S. Line

990

_____ Ft. from E. Line

_____ Ft. from W. Line

	o		
	COMPLETE		

Rice County

Location _____

Rig up _____

Drilling and Remarks:

*10" @ 295**5" @ 3261**Loss 2841**Core 3219**AB 3260**P 124 B O 14 hrs.*

RECORD

Cased _____ in., _____ ft.

Sand _____

Gas _____

Oil _____

Total Depth *3262*

PRODUCTION

1st 24 hrs. Nat. _____

1st 24 hrs. after shot _____

Gas _____ Cu. Ft.

Dry Hole _____

Abandoned _____

Complete for 1189 BOPD. 720 wls.

Date

FEB 8 1950

J. E. TYRA Scout