

Rice

Well No. 4 Ross

Company Cities Service

Lorraine Pool

NORTH

A blank 8x8 grid with directional labels WEST, EAST, SOUTH, and NORTH. The label '0' is in the top-left cell.

KANSAS

Rice

Sec. 11 Twp. 18 R. 8W ✓

Well No. #4 Ross Farm

Cities Service Company

Lorraine Pool


Ft. from N. Line

990' Ft. from S. Line

Ft. from E. Line

330' Ft. from W. Line

NW SW NW

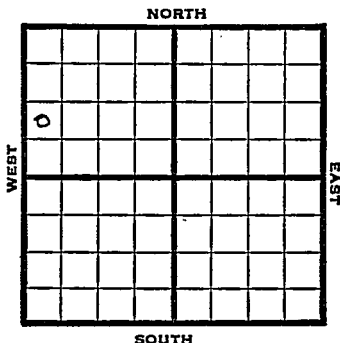

1948

Elev. 1780'

REPORT

9/8

Location

9/14

8" @ 261'

Drlg 1000

9/21

Drlg 2210'

9/29

Lansing 2849'

Simpson 3260'

Arb. 3280'

TD 3283'

5" @ 3281-2725 Oil 13 hrs.

10/6

Pump 235 bbls oil 21 hrs.

10/13

Lans. 2849'

Arb. 3280'

5" @ 3281'

Pump 134 oil Pot.

Gr. 41°

TD 3283'

COMPLETED

Rice County Kansas State
 Map No. _____ Sec. 11 Twp. 18 R. 8W

Well No. 4 Ross

Cities Service

Company

FIRST REPORT

Contractor

NW SWNW

SECTION PLAT

_____ Ft. from N. Line

990 Ft. from S. Line

_____ Ft. from E. Line

330 Ft. from W. Line

Lorraine Pool

Remarks:

Location

Date
 SEP 8 1948

Scout
 S. J. LEWIS

Kansas

Lorraine Pool

Map No. 45 Sec. 11 Twp. 18 R. 8WWell No. 4 Ross


Cities Service

Company

COMPLETE

Contractor

NW SW NW

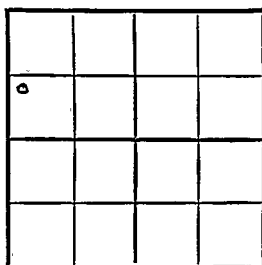E 11 1980
SECTION PLAT Ft. from N. Line990 Ft. from S. Line Ft. from E. Line330 Ft. from W. Line

Rice County

Location Rig up

Drilling and Remarks:

L 1011 2849Qr 832505' C 3281Pump 134 oil out41 2 81

RECORD

Cased in., ft.Sand Gas Oil Total Depth 3283

PRODUCTION

1st 24 hrs. Nat. 1st 24 hrs. after shot Gas Cu. Ft.Dry Hole Abandoned

Date

OCT 13 1948

19

S. J. LEWIS

Scout