


KANSAS**Rice**Section 11 Township 18 Range 8WWell No. 5 RossCompany Cities Service
Geneseo

NORTH

WEST

EAST

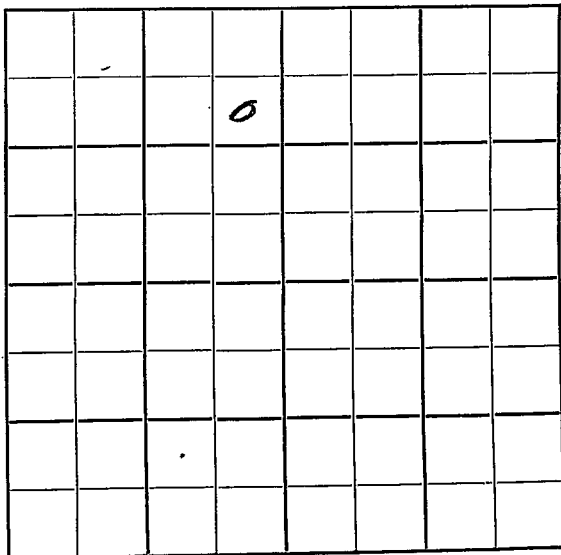

SOUTH

KANSAS

Rice ✓

Sec. 11 Twp. B R. 8W

Well No. 5 Ross Farm

Cities Service

Company

Geneseo Pool


990 Ft. from N. Line

 Ft. from S. Line

330 Ft. from E. Line

 Ft. from W. Line

SE NE NW

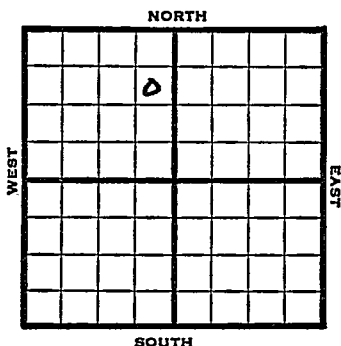

1949 Elev 1772' REPORT

9/28 8" @ 298'
10/5 Drlg 2825'
10/12 Lansing 2835'
Arb. 3244-48'
TD 3248'
5" @ 3246'
10/19 "
10/26 TD 3254'
Pump 183 bbls oil 11 hrs.
11/2 TD 3254'
Arb. 3244'
5" @ 3246'
500 acid
Depth Pot 2791
41° Gr.
Comp

COMPLETED

Map No. _____ Sec. 11 Twp. 18 R. 8W

Well No. 5 Ross

Cities Service

Company

Contractor

SE NE NW


**FIRST REPORT
SECTION PLAT**

990 Ft. from N. Line

_____ Ft. from S. Line

330 Ft. from E. Line

_____ Ft. from W. Line

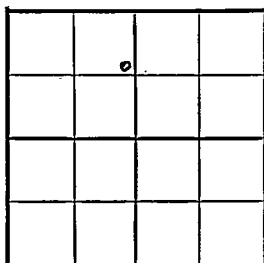

Rice County

Location _____

Rig up _____

Drilling and Remarks:

8" @ 298

RECORD

Cased _____ in., _____ ft.

Sand _____

Gas _____

Oil _____

Total Depth _____

PRODUCTION

1st 24 hrs. Nat. _____

1st 24 hrs. after shot _____

Gas _____ Cu. Ft.

Dry Hole _____

Abandoned _____

Date

SEP 28 1949

19

S. J. LEWIS

Scout

Kansas

Geneseo Pool

Map No. _____ Sec. 11 Twp. 18 R. 8WWell No. 5 Ross

Cities Service

Company

COMPLETE

Contractor

SE NE NW

E11272
SECTION PLAT990 Ft. from N. Line Ft. from S. Line330 Ft. from E. Line Ft. from W. Line

Rice County

	6		

RECORD

Location _____

Cased _____ in., _____ ft.

Rig up _____

Sand _____

Drilling and Remarks:

Gas _____

Oil _____

Total Depth 225 1/2

PRODUCTION

1st 24 hrs. Nat. _____

1st 24 hrs. after shot _____

Gas _____ Cu. Ft.

Dry Hole _____

Abandoned _____

Date

NOV 2 1949 19

S. J. LEWIS Scout