

Section 11 Township 18 Range 8W

Well No. #10 Ross

Company Cities Service Oil

NORTH

| | | | | | | | |
|--|---|--|--|--|--|--|--|
| | 0 | | | | | | |
| | | | | | | | |
| | | | | | | | |
| | | | | | | | |
| | | | | | | | |
| | | | | | | | |
| | | | | | | | |
| | | | | | | | |

WEST

EAST

SOUTH

Sec. 11 Twp. 18 R. 8W

Well No. #10 Ross Farm

Cities Service Oil Company

Lohman & Johnson - Contr. Contractor


330' Ft. from N. Line

_____ Ft. from S. Line

_____ Ft. from E. Line

990' Ft. from W. Line

NE NW NW

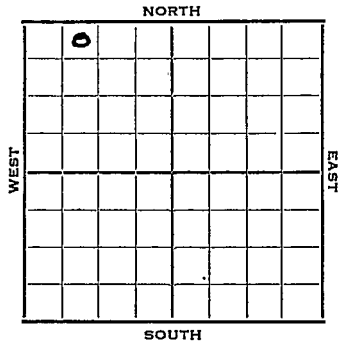

1952 Elev. 1779' REPORT

6/11 Spud 6-4-52
8" @ 302
Drlg. 2680'

6/18 Lans. 2849 Arb. 3276 RTD 3279
5" @ 3277

6/25 CO 3729' P/92 BOPD

7/2 NR

7/9 Spud 6-4-52

Oil well TD 3279' 8" @ 302'
Lans. 2849' Arb. 3276' TD 3279'
5" @ 3277 CO to 3279' P/92 BOPD
Comp. 48 BOPD

COMPLETED

County Rice State KANSAS

Sec. 11 (Blk. Twp.) 18 (Sur. Rge.) 8W Map No.

Operator Cities Service Oil

Well No. 10 Farm Ross

Elev. 1779 Location NE NW NW

| | | | | | |
|---|--|--|--|--|--|
| 0 | | | | | |
| | | | | | |
| | | | | | |
| | | | | | |
| | | | | | |
| | | | | | |
| | | | | | |
| | | | | | |
| | | | | | |
| | | | | | |

FIRST REPORT

330 Ft. From N Line NW

990 Ft. From W Line Quarter

Ist. Report JUN 11 1952

Completion _____

Remarks _____

Lohman & Johnson - Contr

Spudding Date 6-4-52

Drlg. Data _____

8" @ 302 drlg. 2680

J. G. McGEHEE

County Rice State Kansas

Sec. 11 (Blk. Twp.) 18 (Sur. Rge.) 8W Map No.

Operator Cities Service Oil

Well No. 10 Farm Ross

Elev. 1779 Location NE NW NW

| | | | | | |
|---|--|--|--|--|--|
| o | | | | | |
| | | | | | |
| | | | | | |
| | | | | | |
| | | | | | |
| | | | | | |
| | | | | | |
| | | | | | |

330 Ft. From N Line NW

990 Ft. From W Line Quarter

1st. Report

Completion JUL 9 1952

Remarks

Lohman & Johnson - Contr.

Spudding Date 6-4-52

Drlg. Data Oil well TD 3279

8" @ 302 Lans. 2849 Arb. 3276

TD 3279 5" @ 3277 CO to 3279

P/ 92 bopd Comp. 48 bopd