


Section 11 Township 18 Range 8-W

Well No. #9 Ross

Company Cities Service

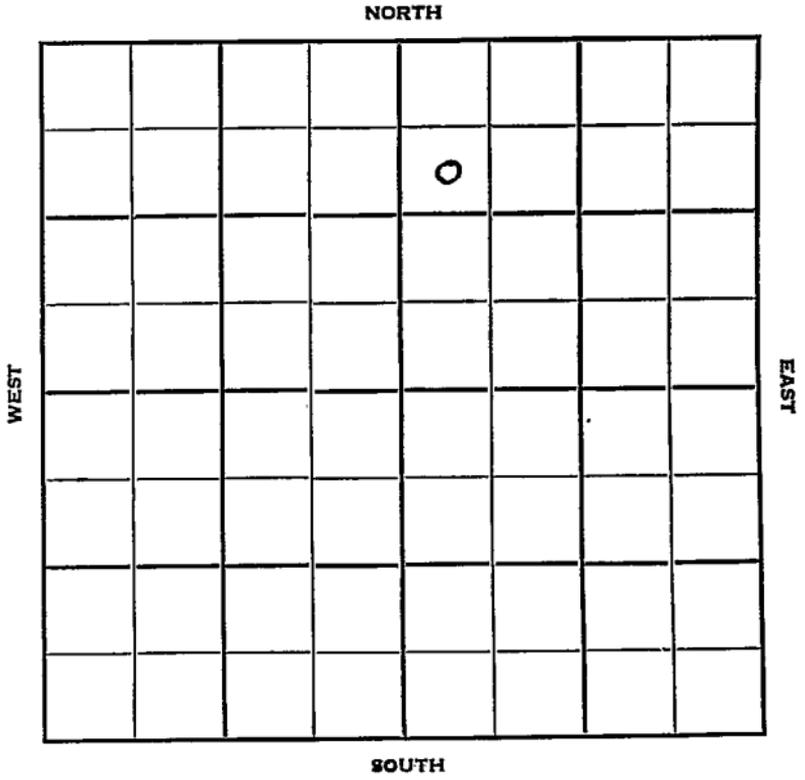

Rice

18

KANSAS 8W ✓

Sec. 11 Twp.

Well No. #9 Ross

Farm

Cities Service

Company

Contractor

Geneseo Pool


990' Ft. from N. Line

Ft. from S. Line

Ft. from E. Line

330' Ft. from W. Line

SW NW NE

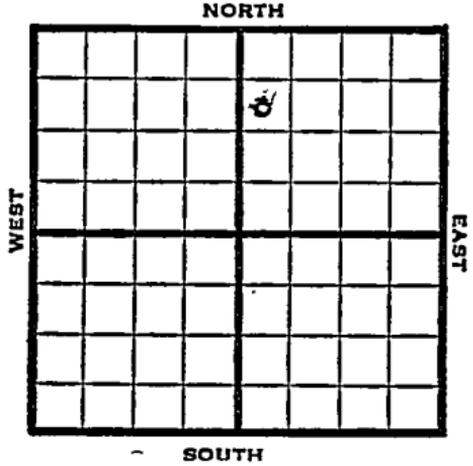

1950

Elev. 1766' REPORT

11/1

RUR

12/6

Spud 11-1-50

Oil Well TD 3247

8" @ 324' Arb. 3241

5" @ 3244' TD 3247

P/283 bopd Comp. 1872 bopd

~~COMPLETED~~

11/1



