


FORM 51 5/4 2-53 T.C.D.
O. W. P. B.

Rice

Section 11 Township 18 Range 8-W

Well No. 2 Zagic

Company Cities Service Oil

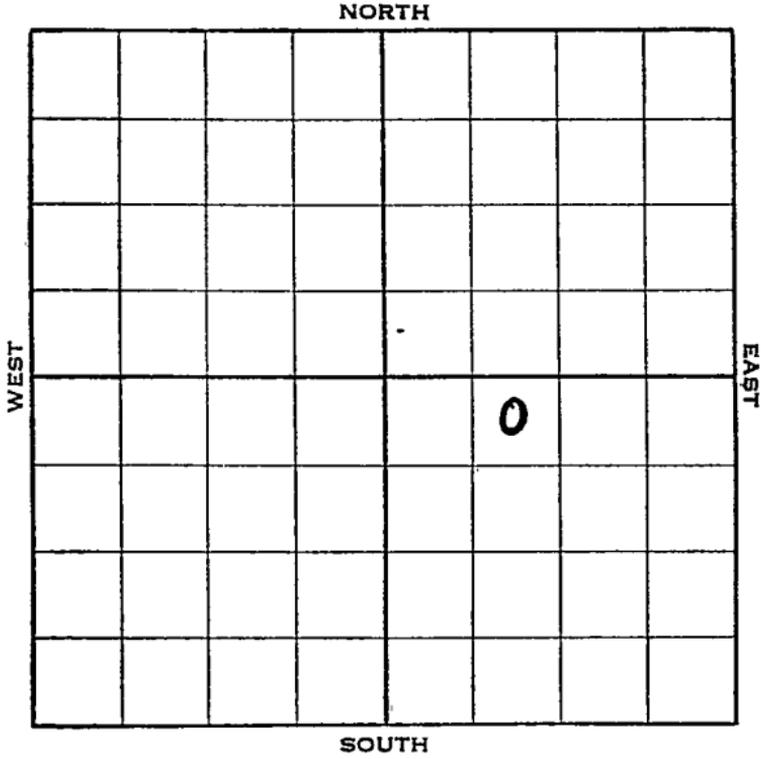

Sec. 11 Twp. 18 R. 8-W

Well No. #2 Zagie Farm _____
Sities Service Oil Company

330 Ft. from N. Line


_____ Ft. from S. Line

_____ Ft. from E. Line

990 Ft. from W. Line

NE NW SE

Elev. 1762

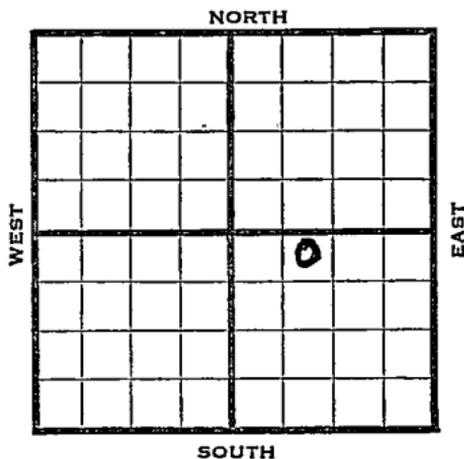

1938	REPORT
6/1	Mat'l.
6/10	10" @ 214'. Drlg. 2040'.
6/17	Arb. 3249'. S.O. 3250-72'. Coring 3274'.
6/24	Sm. S. O. 3272-75'. 6" - 3260'. C. O.
7/1	Drlg. plug 2400' wtr. Recement csg.
7/8	1600' oil in 32 hrs.
7/15	5" liner 3266'. C. O.
7/22	Fsg. liner.
7/29	" "
8/5	" "
8/12	" "
8/19	" "
8/26	" "
9/2	5" liner cemented 3258'. 1100' fluid 16 hrs. 50% oil.
9/9	T. D. 3275'. Pump 43 oil & 660 bbls. water 17 hrs.
9/16	TD 3275' SD.

OVER

1938

9/23 P. B. 3262'. C. O.

9/30 " " " "

10/7 " " " "

10/14 " " " "

10/21 Pump 54 oil & 64 wtr. in 11 hrs.
C. O.

10/26 6" - 3260'.

Arb. 3246'.

T. D. 3275'.

5" liner 3258'.

P. B. 3262'.

Potential 554 bbls., Nat.

COMPLETED

O. W. P. B.

1955

4/20

D&A - TD 3275'

Lans. 2835', Sdy Cong. 3180', Ch.

Cong. 3196', Simp. 3237', Ero Arb.

3240', Arb. 3246'

5" @ 3258'

OTD 3275'

PB 3191', 33/3191-320, 43/3202-13,

23/2317-23, 7/3226-28, 9/3202-10,

4 gwph

PB 3208'

A-frac

D&A

FIRST REPORT

Y

ABANDONED

Rice KANSAS

Map No. 45 Sec. 11 Twp. 18 R. 8WWell No. 2 ZagieCities Service Oil Company

Contractor

FIRST REPORT

NE NW SE

330 Ft. from N. Line

_____ Ft. from S. Line

_____ Ft. from E. Line

990 Ft. from W. Line

SECTION PLAT

		0	

Location _____

Rig up _____

Drilling and Remarks:

Matl.

RECORD

Cased _____ in., _____ ft.

Sand _____

Gas _____

Oil _____

Total Depth _____

PRODUCTION

1st 24 hrs. Nat. _____

1st 24 hrs. after shot _____

Gas _____ Cu. Ft.

Dry Hole _____

Abandoned _____

Date

JUN 1 - 1938

19

H. D. Hatfield Scout

Map No. 45 Sec. 11 Twp. 18 R. 8W

Well No. 2-Zagic

Cities Service Company

Contractor

NE NW SE

COMPLETED

SECTION PLAT

		0	

330 Ft. from N. Line

_____ Ft. from S. Line

_____ Ft. from E. Line

990 Ft. from W. Line

Location _____

Rig up _____

Drilling and Remarks:

5" Liner 3258

P.B. 3262

POT 554
NAT

RECORD

Cased 6 in., 3260 ft.

~~Sand~~ ARB 3246

Gas _____

Oil _____

Total Depth 3275

PRODUCTION

1st 24 hrs. Nat. _____

1st 24 hrs. after shot _____

Gas _____ Cu. Ft.

Dry Hole _____

Abandoned _____

Date

OCT 26 1938

19

H. D. Hatfield

Scout

