Form 51—5M—11-38—Palace


Rice

KANSAS

Section 11 Township 18 Range 8-W

Well No. #3 Zagic

Company Cities Service Oil

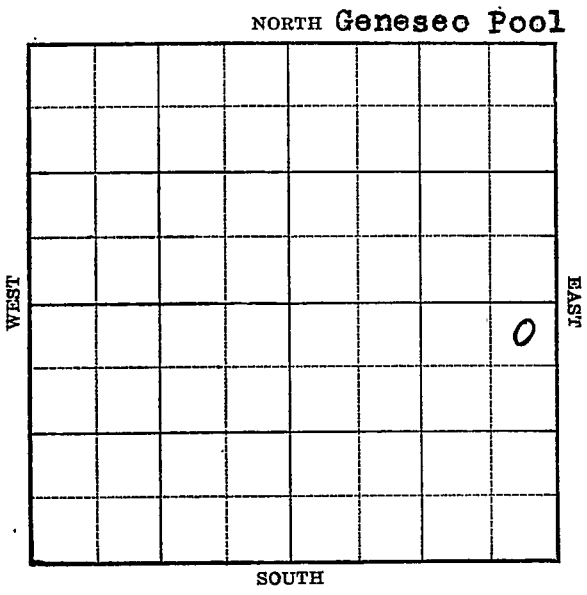

FORM 252-A 5M 4-39 KANSAS Rice

Sec. 11 Twp. 18 R. 8W

Well No. #3 Zagic Farm

Cities Service Oil Company


(Geneseo Pool)

330 Ft. from N. Line

_____ Ft. from S. Line

330 Ft. from E. Line

_____ Ft. from W. Line

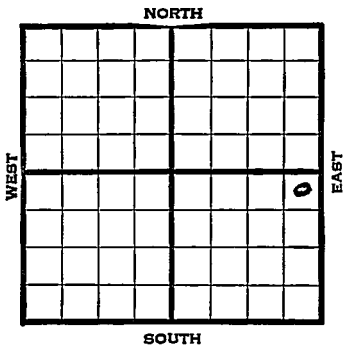

Elev. 1765

1939	REPORT
6/7	Rotary
6/16	8" - 235' Drlg. 1120'
6/23	Twisted off drill pipe.
	Skid rig 22' south.
	Drlg. 875'
6/29	Drlg. 2665'
7/6	Arb. 3257' S.O. T.D. 3258'
	Run 5".
7/13	5" - 3253' T.D. 3288'
	2 BW per hour. Shut down.
7/19	Arb. 3248' (Corrected)
	T.D. 3286' H.F.W.
	ABANDONED

Form 26—1M Bks.—2-29

KANSAS Rice

Map No. 45 Sec. 11 Twp. 18 R. 8W

Well No. 3 Zagic

Cities Service Oil Company

Contractor

FIRST REPORT

NE SE

330 Ft. from N. Line


Ft. from S. Line

330 Ft. from E. Line

Ft. from W. Line

GENESEO POOL

SECTION PLAT

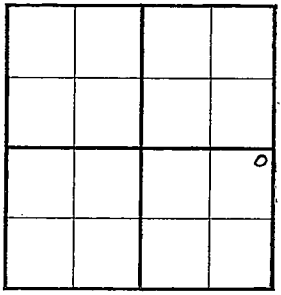

Location

Rig up

Drilling and Remarks:

ROTARY

RECORD

Cased in., ft.

Sand

Gas

Oil

Total Depth

PRODUCTION

1st 24 hrs. Nat.

1st 24 hrs. after shot

Gas Cu. Ft.

Dry Hole

Abandoned

Date

JUN 7 1939 19

S. J. LEWIS Scout

Form 26—1M Bks.—2-29

KANSAS

Rice

Map No. 45 Sec. 11 Twp. 18 R. 8W

Well No. 3 Zagic

Cities Service Oil Company

Contractor

ABANDONED

NE SE

330 Ft. from N. Line


Ft. from S. Line

330 Ft. from E. Line

Ft. from W. Line

GENESEO POOL

SECTION PLAT

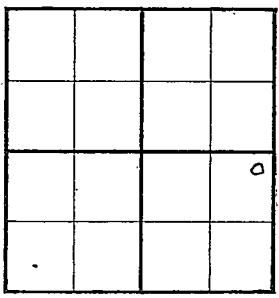

Location

Rig up

Drilling and Remarks:

Cu X 3248 @ Drill to 6

HPW

RECORD

Cased in., ft.

Sand

Gas

Oil

Total Depth 3286

PRODUCTION

1st 24 hrs. Nat.

1st 24 hrs. after shot

Gas Cu. Ft.

Dry Hole

Abandoned

Date

JUL 19 1939 19

S. J. LEWIS Scout