


Section 11 Township 18 Range 8WWell No. #4 ZajioCompany Cities Service

NORTH

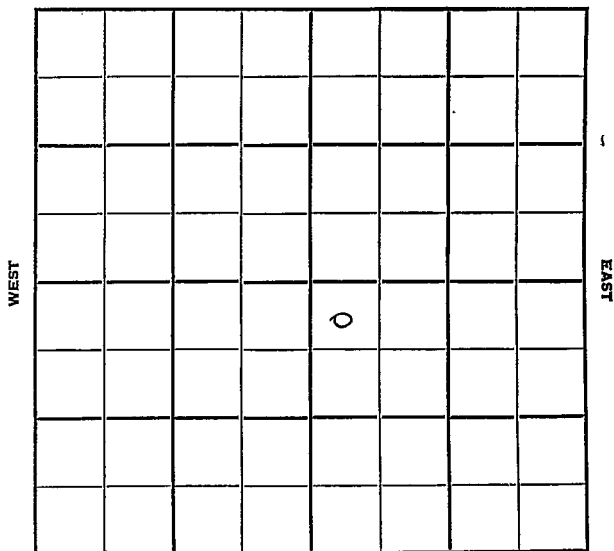

Rice KANSAS

Sec. 11 Twp. 18 R. 8 W ✓

Well No. # 4 Zajic Farm

Cities Service Company

Braden Drlg. Contractor

Geneseo Pool


330 Ft. from N. Line

 Ft. from S. Line

 Ft. from E. Line

330 Ft. from W. Line

NW NW SE

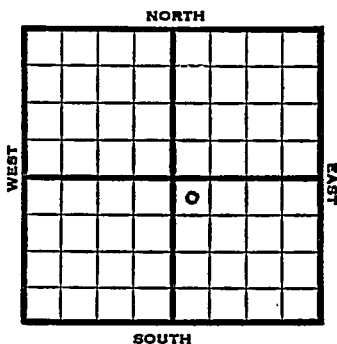

1951 Elev. 1767' REPORT

3/14 Location

6/5 Spud 3-15-51
Oil Well TD 3265
8" @ 316
Lans. 2831 Cong. 3194
Simp 3227 Arb. 3234
5" @ 3235 TD 3262
P/98 bo 22 hr DD 3265 1000 A
Comp. 172 bopd

COMPLETED

J. E. TVRA

J. E. TYRA