


Section.....12.....Township.....18.....Range 8-W

Well Number.....1 Fuller


Company.....Continental et al

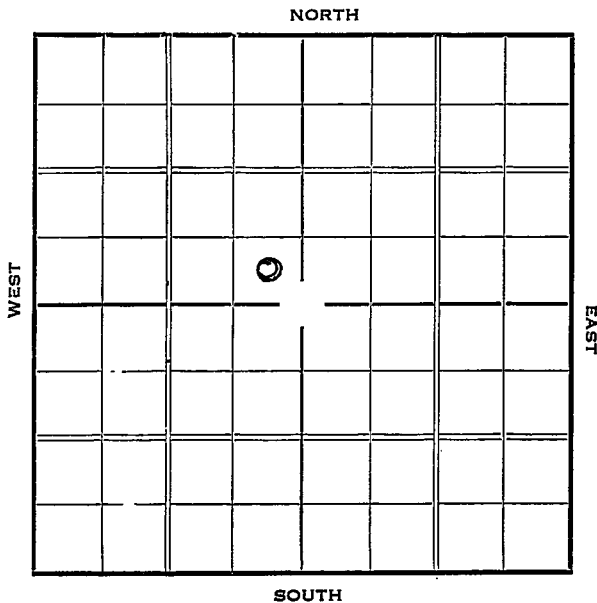

Sec. 12 Twp. 18 R. 8-W

Well No. #1 Fuller Farm
Continental et al Company

 Ft. from N. Line
330 Ft. from S. Line
 Ft. from E. Line
330 Ft. from W. Line
 Elev. 1733

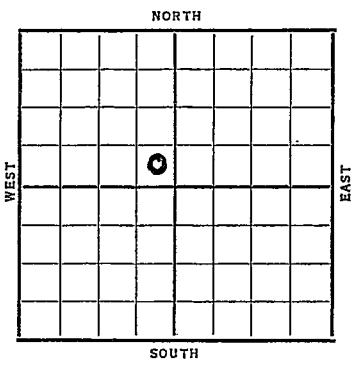

Date	REPORT
1937	
4/14	Rig
4/23	13" @ 197'. Drlg. 925'.
4/30	Drlg. 3095'.
5/7	Sil. 3244'. 7" @ 3244'. T.D. 3250'. RUST.
5/14	1500' water 3248-52'. 2600' water 3254' T.D.
5/21	T.D. 3254' SDO
5/26	7" @ 3244'. Sil. 3244'. T.D. 3254'.
	ABANDONED

Map No. _____ Sec. 12 Twp. 18 R. 5W

Well No. 1 Fuller

Continental & Co. Company

Contractor

SECTION PLAT

		o	

_____ Ft. from N. Line

330 Ft. from S. Line

_____ Ft. from E. Line

330 Ft. from W. Line

FIRST REPORT

Location _____

Rig up _____

Drilling and Remarks:

Rig

RECORD

Cased _____ in., _____ ft.

Sand _____

Gas _____

Oil _____

Total Depth _____

PRODUCTION

1st 24 hrs. Nat. _____

1st 24 hrs. after shot _____

Gas _____ Cu. Ft.

Dry Hole _____

Abandoned _____

Date

APR 1 ± 1937 ₁₉

S. J. LEWIS Scout

Rice KANSAS

Map No. 45 Sec. 12 Twp. 18 R. 8W

Well No. 1-Fuller

Continental Company

Contractor

ABANDONED

SECTION PLAT

_____ Ft. from N. Line

330 Ft. from S. Line

_____ Ft. from E. Line

330 Ft. from W. Line

		0	

Location _____

Rig up _____

Drilling and Remarks:

DXA

RECORD

Cased 7 in., 3244 ft.

Sand 511 3244

Gas _____

Oil _____

Total Depth 3254

PRODUCTION

1st 24 hrs. Nat. _____

1st 24 hrs. after shot _____

Gas _____ Cu. Ft.

Dry Hole _____

Abandoned _____

Date

MAY 26 1937 19

H. D. Hatfield

Scout