Rice


FORM 51

KANSAS

Section 12 Township 18 Range 8W

Well No. #1 Fuller

Company Ashmar Oil

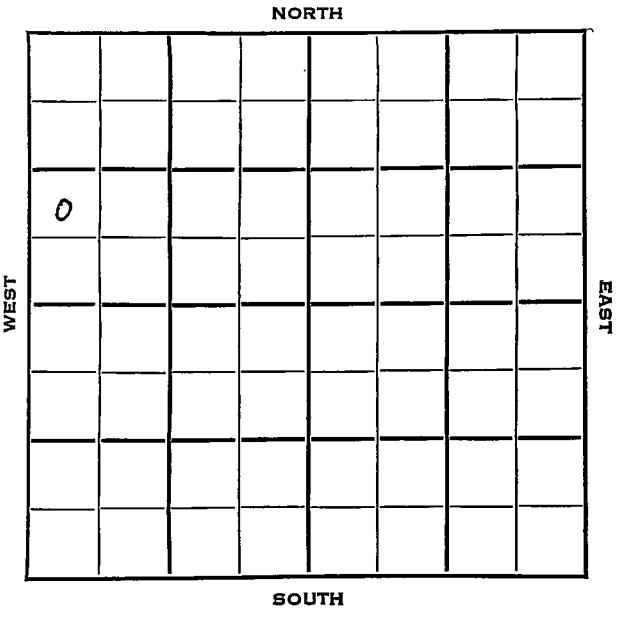

Rice KANSAS

SEC.	TWP.	R.
12	18	8W

WELL NO.

#1 Fuller FARM

COMPANY

Ashmar Oil

CONTRACTOR

Ashmar

Geneseo-Edwards Pool


_____ Ft. from N. Line

990 Ft. from S. Line

_____ Ft. from E. Line

330 Ft. from W. Line

NW SW NW

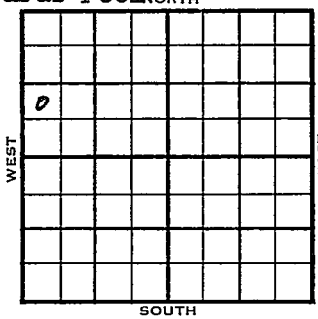

	ELEVATION	REPORT
1954	1746'	
1/27		Location
2/3		8" @ 172' w/125 sks Drlg. 1550'
2/10		Br li 2782' Lans 2808' Cong. 3182 DST 3153-3200, 1 hr, 970' GCSW 500# Drlg. 3242'
2/17		Spud 1-29-54 D&A TD 3265' 8" @ 172' Br lime 2782', Lans 2808', Cong 3182' DST 3153-3200, opn 1 hr., rec. 970' gcsw, 500# Simp. 3212', Arb. 3254' DST 3256-65', opn 1 hr., rec. 2040' SW, 990# TD 3265' D&A

ABANDONED

DX-78

FORM 275 FOR SALE BY KANSAS BLUE PRINT CO.

County Rice State Kansas

Sec. 12 (Blk. Twp.) 18 (Sur. Rge.) 8W Map No.

Operator Ashmar Oil

Well No. 1 Farm Fuller

Elev. Location NW SW NW



990 Ft. From S Line NW

330 Ft. From W Line Quarter

1st. Report JAN 27 1954

Completion

Remarks

Ashmar - Contr.

Spudding Date

Drlg. Data Geneseo-Edwards Pool

Location

J. G. McGEHEE

FORM 275 FOR SALE BY KANSAS BLUE PRINT CO.


County Rice State Kansas

Sec. 12 (Blk. Twp.) 18 (Sur. Rge.) 8W Map No.

Operator Ashmar Oil

Well No. 1 Farm Fuller

Elev. 1746 Location NW SW NW

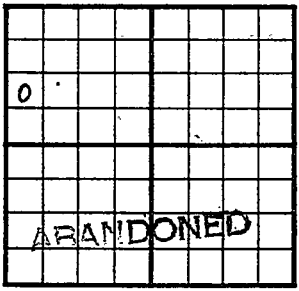

990 Ft. From S Line NW

330 Ft. From W Line Quarter

1st. Report

Completion FEB 17 1954

Remarks Geneseo-Edwards Pool

Ashmar - Contr.

Spudding Date 1-29-54

Drlg. Data D & A TD 3265

8" @ 172 Br. lime 2782 Lans. 2808

Cong. 3182 DST 3153-3200 open 1 hr.

Rec. 970' gcsw 500# Simp. 3212

Arb. 3254 DST 3256-65 open 1 hr.

Rec. 2040' sw 990# TD 3265

D & A

J. G. McGEHEE