
Form 51-5M-12-36 Com'l KANSAS Rice

Section 12 Township 18 Range 8-W

Well Number 1 Rose Michekls

Company Continental Oil

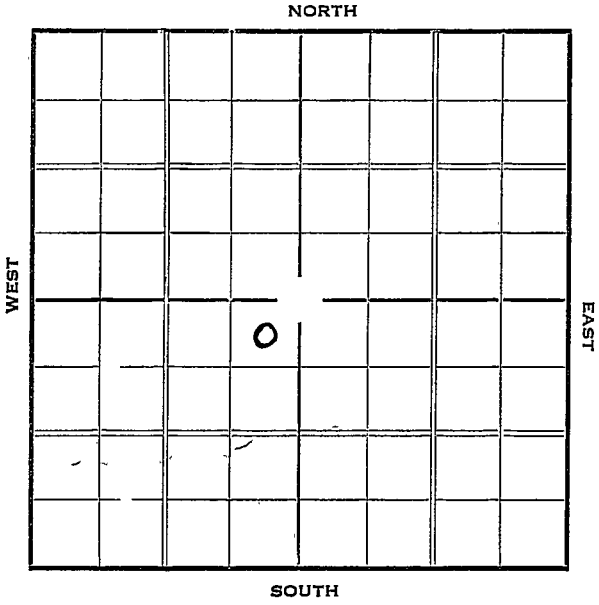

Form 252-A—5M—7-36—Palace KANSAS RICE

Sec. 12 Twp. 18 R. 8W

Well No. 1 Rose Mickekls Farm

Continental Oil Company


330 Ft. from N. Line

Ft. from S. Line

330 Ft. from E. Line

Ft. from W. Line

Elev. 1744

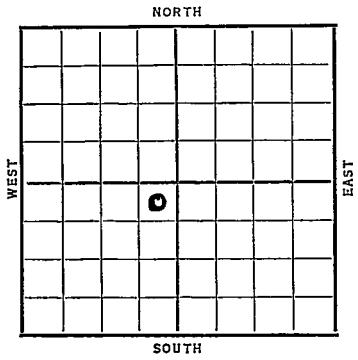

Date 1937	REPORT
1/27	Cellar
2/4	Rig
2/11	"
2/19	Rigging up.
2/26	12" @ 212'. WOC
3/4	Drlg. 2530'
3/11	Sil 3201' Set 7" RUST
3/18	TD 3210' RUST
3/24	Sil. 3201'.
	T. D. 3212'.
	Potential 1241 natural.
	COMPLETED

Form 26—1M Bks.—2-29 KANSAS


Map No. 45 Sec. 12 Twp. 18 R. 8W

Well No. 1 Rose Mickels

Continental Oil Company

Contractor

SECTION PLAT

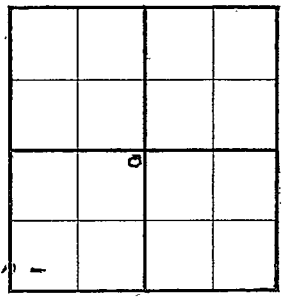

330 Ft. from N. Line

Ft. from S. Line

330 Ft. from E. Line

Ft. from W. Line

(Duplicate) Pittman

FIRST REPORT

Location

Rig up

Drilling and Remarks:

Cellar

RECORD

Cased in., ft.

Sand

Gas

Oil

Total Depth

PRODUCTION

1st 24 hrs. Nat.

1st 24 hrs. after shot

Gas Cu. Ft.

Dry Hole

Abandoned

Date

JAN 27 1937 19

S. J. LEWIS Scout

Form 26—1M Bks.—2-29 KANSAS Rice


Map No. 45 Sec. 12 Twp. 18 R. 8W

Well No. 1 Rose Michaelis

Continental Company

Contractor

SECTION PLAT

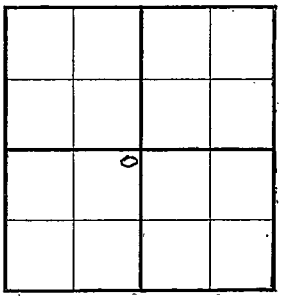

330 Ft. from N. Line

Ft. from S. Line

330 Ft. from E. Line

Ft. from W. Line

COMPLETED

Location

Rig up

Drilling and Remarks:

Sil 3201

Potential

124/natural

RECORD

Cased in., ft.

Sand

Gas

Oil

Total Depth 3212

PRODUCTION

1st 24 hrs. Nat.

1st 24 hrs. after shot

Gas Cu. Ft.

Dry Hole

Abandoned

Date

MAR 24 1937 19 S. I. LEWIS Scout