


Section 12 Township 18 Range 8-W

Well No. 2 Johnson

Company Continental et al

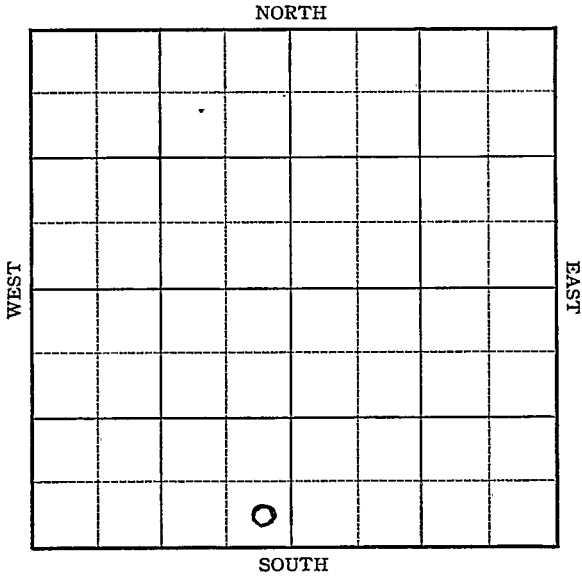

KANSAS Rice

Sec. 12 Twp. 18 R. 8-W

Well No. #2 Johnson Farm


Continental et al Company

_____ Ft. from N. Line

330 Ft. from S. Line

330 Ft. from E. Line

_____ Ft. from W. Line

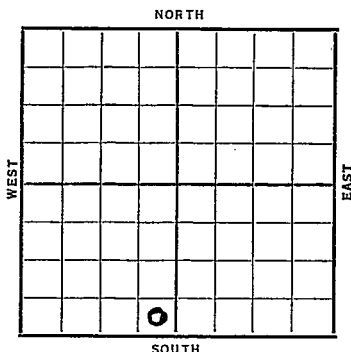

Date	REPORT
1938	
1/26	Location
2/4	R.U.R.
2/11	10" @ 225'. Drl g. 2105'.
2/18	Arb. 3159'. 7" @ 3160'. T.D. 3161'. RUST.
2/26	" " "
3/4	T.D. 3240'. 2000 acid. 3150' oil.
3/9	7" @ 3160'. Arb. 3159'. T.D. 3240'. 2000 acid.
	Potential 2837 bbls.
	COMPLETED

