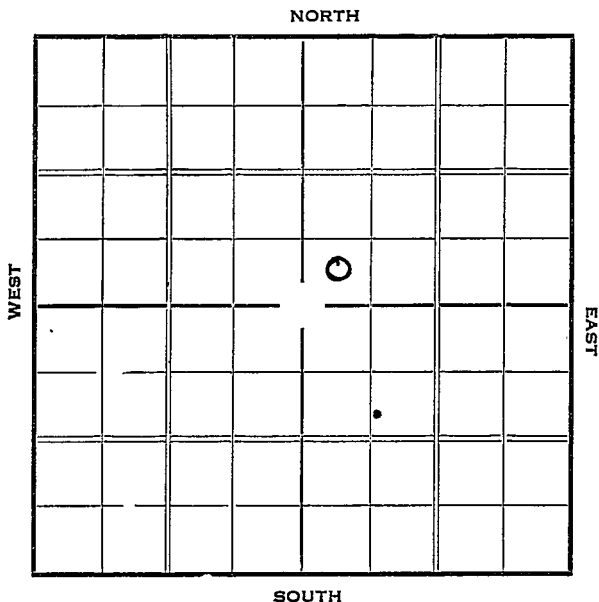


Section 12 Township 18 Range 8-WWell Number. #2
1 - Fuller ~~KA~~Company. Continental et al

Rice KANSASMap No. 45 Sec. 12 Twp. 18 R. 8 WWell No. 1 - Fuller "A"Continental etal Company

Contractor

FIRST REPORT

SECTION PLAT

		o	

_____ Ft. from N. Line

330 Ft. from S. Line

_____ Ft. from E. Line

330 Ft. from W. LineLocation ✓

Rig up _____

Drilling and Remarks:

RECORD

Cased _____ in., _____ ft.

Sand _____

Gas _____

Oil _____

Total Depth _____

PRODUCTION

1st 24 hrs. Nat. _____

1st 24 hrs. after shot _____

Gas _____ Cu. Ft.

Dry Hole _____

Abandoned _____

Date

APR 28 1937

19

H. D. Hatfield Scout

Rice **KANSAS**Map No. *45* Sec. *12* Twp. *18* R. *8 W*Well No. *2 - Fuller**Continental* Company

Contractor

CORRECTION

Ft. from N. Line

330 Ft. from S. Line

Ft. from E. Line

330 Ft. from W. Line

SECTION PLAT

		0	

Location _____

Rig up _____

Drilling and Remarks:

*first reported
as #1 Fuller "A"*

RECORD

Cased _____ in., _____ ft.

Sand _____

Gas _____

Oil _____

Total Depth _____

PRODUCTION

1st 24 hrs. Nat. _____

1st 24 hrs. after shot _____

Gas _____ Cu. Ft.

Dry Hole _____

Abandoned _____

Date

JUN 9 1937

H. D. Hatfield

Scout

Rice KANSAS

Map No. _____ Sec. 12 Twp. 18 R. 8^WWell No. 2 - FullerContinental Company

Contractor _____

ABANDONED

SECTION PLAT

		0	

_____ Ft. from N. Line

330 Ft. from S. Line

_____ Ft. from E. Line

330 Ft. from W. Line

Location _____

Rig up _____

Drilling and Remarks:

D & A

RECORD

Cased _____ in., _____ ft.

Sand 511 3268

Gas _____

Oil _____

Total Depth 3275

PRODUCTION

1st 24 hrs. Nat. _____

1st 24 hrs. after shot _____

Gas _____ Cu. Ft.

Dry Hole _____

Abandoned _____

Date

JUN 30 1919

H. D. Hatfield

Scout