

Rice

KANSAS


Form 51-5M 5-37 Petrol

O.W.W.O.

Section 12 Township 18 Range 8-W

Well No. 2 ~~Nickolls~~ ^{Michels} R. MITCHELL


Company Continental

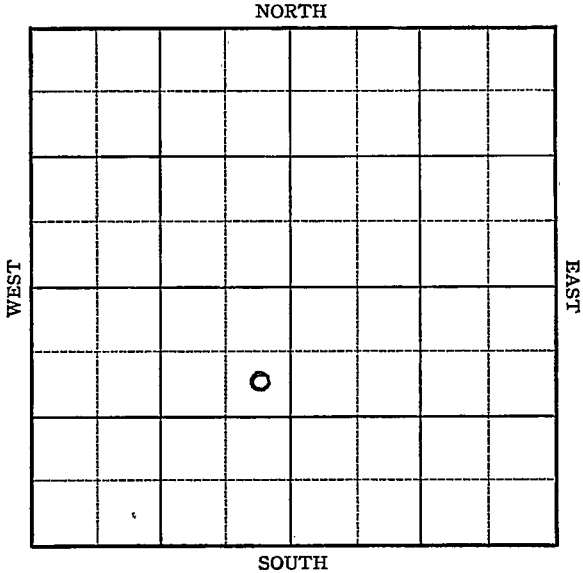

O.W.W.O. KANSAS Rice

Sec. 12 Twp. 18 R. 8-WWell No. #2 ~~Nicholls~~ Mitchells FarmContinental Company990 Ft. from N. Line Ft. from S. Line330 Ft. from E. Line Ft. from W. Line

Elev. 1751

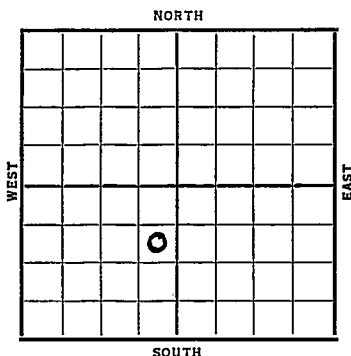

Date	REPORT
1937	
9/22	Location
10/2	R. R.
10/8	10" @ 211'. Drlg. 335'.
10/15	Drlg. 2750'.
10/22	Sil. 3189'. 7" @ 3189'.
	T.D. 3190'. RUST. No shows
	reported.
10/29	T.D. 3246'. 2100' oil.
	Acidizing.
11/3	7" @ 3189'.
	Sil. 3188'.
	T.D. 3246'.
	4000 acid.
	Potential 1622 bbls.
	COMPLETED
	OVER

1955

O.W.W.O.

1/19 Oil Well
TD 3246'
TD 3246'
Arb. 3188'
CO to 3246'
Heeb 2636', Br. Lime 2764', Lans
2792' Cong 3150' Arb. 3193'
PB 3201'
SP 3180
60/ 3160-80 frac.
Comp 345 bopd. 18 bw.

FIRST REPORT
✓
COMPLETED

Rice KANSAS

Map No. 45 Sec. 12 Twp. 18 R. 825Well No. 2 NickellsContinental Company

Contractor

FIRST REPORT

SECTION PLAT

990 Ft. from N. Line

_____ Ft. from S. Line

330 Ft. from E. Line

_____ Ft. from W. Line

Location ✓

Rig up _____

Drilling and Remarks:

RECORD

Cased _____ in., _____ ft.

Sand _____

Gas _____

Oil _____

Total Depth _____

PRODUCTION

1st 24 hrs. Nat. _____

1st 24 hrs. after shot _____

Gas _____ Cu. Ft.

• Dry Hole _____

Abandoned _____

Date

SEP 22 1937

19

H. D. Hatfield Scout

Rice KANSAS

Map No. 45 Sec. 12 Twp. 18 R. 8WWell No. 2 - MickelsContinental Company

Contractor

CORRECTION

SECTION PLAT

	0		

990 Ft. from N. Line Ft. from S. Line330 Ft. from E. Line Ft. from W. LineLocation Rig up

Drilling and Remarks:

*farm name
first reported
as # 2 Mickels
should have been
2 mickels*

RECORD

Cased in., ft.Sand Gas Oil Total Depth

PRODUCTION

1st 24 hrs. Nat. 1st 24 hrs. after shot Gas Cu. Ft.Dry Hole Abandoned

Date

SEP 29 1937 19

H. D. Hatfie.

Scout

Rice

KANSAS

Map No. 45 Sec. 12 Twp. 18 R. 8WWell No. 2 Michekl'sContinental Oil Company

Contractor

COMPLETED

SE NE SW

990 Ft. from N. Line Ft. from S. Line330 Ft. from E. Line Ft. from W. Line

SECTION PLAT

Location Rig up

Drilling and Remarks:

4000 AcidPOT- 1622

RECORD

Cased 7 in., 3189 ft.Sand 511 3188Gas Oil Total Depth 3246


PRODUCTION

1st 24 hrs. Nat. 1st 24 hrs. after shot Gas Cu. Ft.Dry Hole Abandoned

Date

NOV 3 1937 19H. D. Hatfield Scout

O.W.W.O.

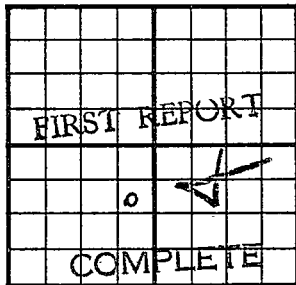County Rice State KansasSec. 12 (Blk.) 18 (Sur.) 8W Map No.Operator ContinentalWell No. 2 Farm R. MitchellElev. 1751 Location SE NE SW990 Ft. From N Line SW330 Ft. From E Line Quarter1st. Report JAN 1 9 1955Completion JAN 1 9 1955Remarks O.W.W.O.

Spudding Date

Drlg. Data Oil well TD 3246TD 3246 Arb. 3188 CO to 3246Heeb. 2636 Br. line 2764 Lens. 2792Cong. 3150 Arb. 3193 PB 3201 SP 318060/ 3160-80 fracComp. 345 bopd 18 bw

FABEN GILS.