

Rice

KANSAS


O. W. P. B.

8W

Section 12 Township 18 Range ~~18~~ 19

Well No. 2 - Wood

Company Continental et al

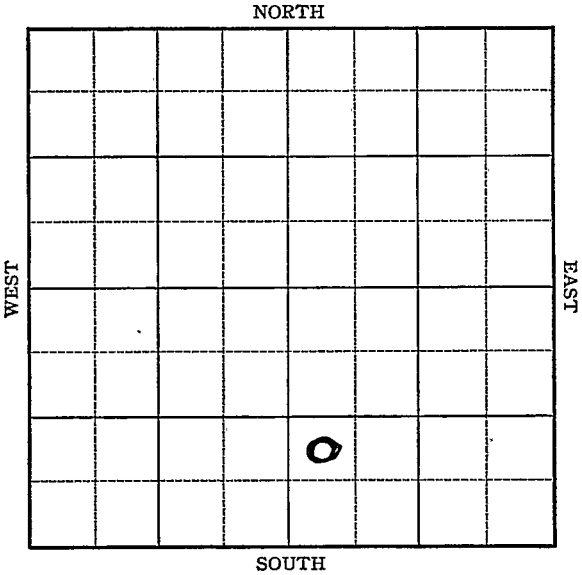

1956

O. W. P. B.

3-14 OTD 3240
7" @ 3177
PB 3203 24/ 3163-69, 36/ 3148-57
sd-frac
Comp. 25 bopd, 4 bw
C. 3141
A. 3175

COMPLETED

Pine KANSAS

Map No. _____ Sec. 12 Twp. 18 R. 8W

Well No. 2-Wood

Continental etal Company

Contractor

FIRST REPORT

SECTION PLAT

		0	

_____ Ft. from N. Line

990 Ft. from S. Line

_____ Ft. from E. Line

330 Ft. from W. Line

Location _____

Rig up _____

Drilling and Remarks:

PUR

RECORD

Cased _____ in., _____ ft.

Sand _____

Gas _____

Oil _____

Total Depth _____

PRODUCTION

1st 24 hrs. Nat. _____

1st 24 hrs. after shot _____

Gas _____ Cu. Ft.

Dry Hole _____

Abandoned _____

Date

SEP 1 1937 19 H. D. Hatfield Scout

Rice KANSAS

Map No. _____ Sec. 12 Twp. 18 R. 8WWell No. 2 Wood

_____ Continental etal _____ Company

_____ Contractor

COMPLETED

NW SW SE

_____ Ft. from N. Line

990 Ft. from S. Line

_____ Ft. from E. Line

330 Ft. from W. Line

SECTION PLAT

		0	

Location _____

Rig up _____

Drilling and Remarks:

3000 AcidP. 343/4 + 296/4POT- 1777

RECORD

Cased 7 in., 3172 ft.Sand 511 3172Gas (Corrected)

Oil _____

Total Depth 3240

PRODUCTION

1st 24 hrs. Nat. _____

1st 24 hrs. after shot _____

Gas _____ Cu. Ft.

Dry Hole _____

Abandoned _____

Date

OCT - 6 1934 19E. D. Hatfield Scout

O. W. P. B
OWPB

FORM 513 REV. SUNRAY

County Rice Elev. 1750
Sec. 12 Twp. 18 Rge. 8W
Company Continental etal.
FarmName Wood No. 2

TOPS	DEPTH	LOG	DATUM	Loc. in Sec.
Anh.				NW SW SE
Tr.				
H.				
Tr.				
Dg.				
Bl.				
L.				Geol.
K.C.				Contr.
B.K.C.				
Ce.				
C.	3171			
M.				
M.				Pool
K.				Geneseo-Edwards
Mz.				
Mq.				
V.				
S.				
S.	3175			
A.				
R.				
PE.				
G.				
T.D.				

Date Comm.

MAR 1 4 1956

OTD 3240 7" @ 3177 PB 3203

24/ 3163-69 36/ 3148-57 sd-frac

Comp. 25 bopd 4 bw

FIRST REPORT
MAR 14 1956
COMPLETE