


Section 12 Township 18 Range 8-W

Well No. #3 Wood

Company Continental Oil etal

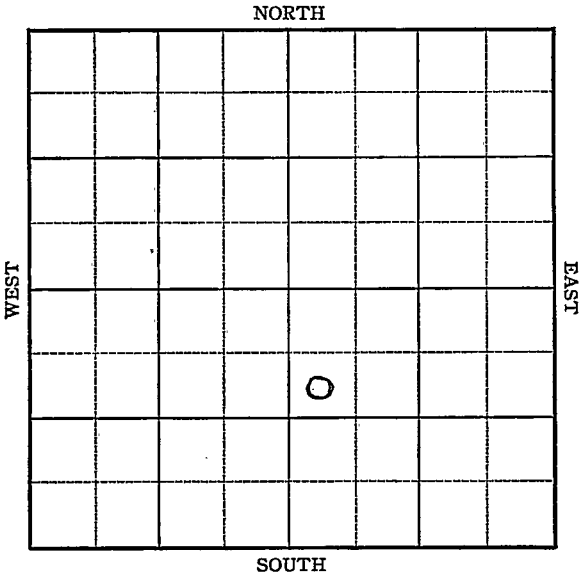

Map No. 45 Sec. 12 Twp. 18 R. 8WWell No. 3 WoodContinental Oil etal Company

Contractor

FIRST REPORT

SECTION PLAT

SW NW SE
990 Ft. from N. Line Ft. from S. Line Ft. from E. Line330 Ft. from W. Line

		0	

Location Rig up

Drilling and Remarks:

BRR

RECORD

Cased in., ft.Sand Gas Oil Total Depth

PRODUCTION

1st 24 hrs. Nat. 1st 24 hrs. after shot Gas Cu. Ft.Dry Hole Abandoned

Date

NOV 17 1937 19 H. D. Hatfield Scout

Rice

KANSAS

Map No. 45 Sec. 12 Twp. 18 R. 8WWell No. 3 WoodContinental Oil et al CompanyA Contractor

COMPLETED

SECTION PLAT

		0	

SW NW SE

990 Ft. from N. Line Ft. from S. Line Ft. from E. Line330 Ft. from W. LineLocation Rig up

Drilling and Remarks:

zoo acidPOT-2028

RECORD

Cased 7 in. 3175 ft.Sand sil 3174Gas Oil Total Depth 3235

PRODUCTION

1st 24 hrs. Nat. 1st 24 hrs. after shot Gas Cu. Ft.Dry Hole Abandoned

Date

DEC 2 2 1937

19

H. D. Hatfield

Scout