


# KANSAS Rice

FORM 51 5M 2-38 TPCO.

Section 12 Township 18 Range 8-W

Well No. 5 Wood

Company Continental

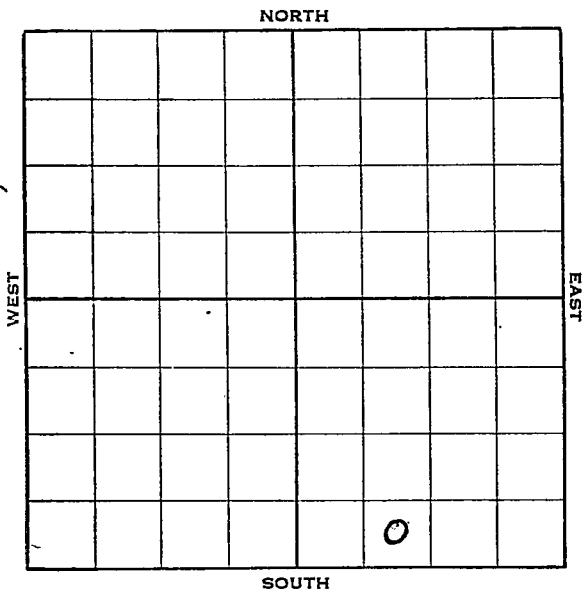

KANSAS

Rice

Sec. 12 Twp. 18 R. 8-W

Well No. #5 Wood Farm

Continental Company


\_\_\_\_\_ Ft. from N. Line

330 Ft. from S. Line

\_\_\_\_\_ Ft. from E. Line

990 Ft. from W. Line

Elev. 1746

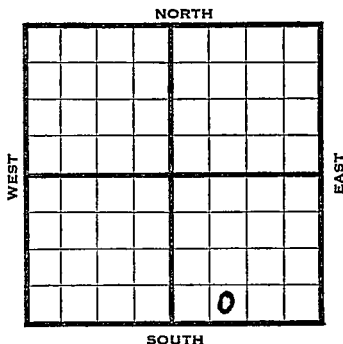

1938	REPORT
8/24	R. R.
9/2	S. H.
9/9	Arb. 3158'. 7" - 3159'.
	T.D. 3160'. RUST. No shows.
9/16	TD 3225'. 3100' oil.
9/21	7" at 3159'.
	Arb. 3158'.
	T. D. 3225'.
	Potential 2461 bbls. natural.
	COMPLETED

Map No. 45 Sec. 12 Twp. 18 R. 8WWell No. 5 WoodContinental

Company

Contractor

## FIRST REPORT

SE SW SE

\_\_\_\_\_ Ft. from N. Line

330 Ft. from S. Line

\_\_\_\_\_ Ft. from E. Line

990 Ft. from W. Line

## SECTION PLAT

			o

Location \_\_\_\_\_

Rig up \_\_\_\_\_

Drilling and Remarks:

RR

## RECORD

Cased \_\_\_\_\_ in., \_\_\_\_\_ ft.

Sand \_\_\_\_\_

Gas \_\_\_\_\_

Oil \_\_\_\_\_

Total Depth \_\_\_\_\_

## PRODUCTION

1st 24 hrs. Nat. \_\_\_\_\_

1st 24 hrs. after shot \_\_\_\_\_

Gas \_\_\_\_\_ Cu. Ft.

Dry Hole \_\_\_\_\_

Abandoned \_\_\_\_\_

Date

AUG 24 1938

19

H. D. Hatfield

Scout

Map No. 45 Sec. 12 Twp. 18 R. 8WWell No. 5 WoodContinental

Company

Contractor

## SECTION PLAT

SE SW SE

Ft. from N. Line

330 Ft. from S. Line

Ft. from E. Line

990 Ft. from W. Line

			0

Location \_\_\_\_\_

Rig up \_\_\_\_\_

Drilling and Remarks:

## RECORD

Cased 7 in., 3159 ft.Sand Arb 3158

Gas \_\_\_\_\_

Oil \_\_\_\_\_

Total Depth 3225

## PRODUCTION

1st 24 hrs. Nat. \_\_\_\_\_

1st 24 hrs. after shot \_\_\_\_\_

Gas \_\_\_\_\_ Cu. Ft.

Dry Hole \_\_\_\_\_

Abandoned \_\_\_\_\_

POT 2461  
NAT

Date  
SEP 21 1938

19

Natfield Scout  
By: Paul